


# CORNER RECORD

Document Number CR-14-84

City of \_\_\_\_\_

County of San Joaquin, California

Brief Legal Description Parcel "1", Per Parcel Map 16-100, S.J.C.R.

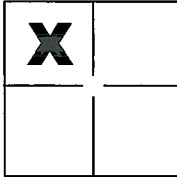

### CORNER TYPE

Government Corner  Control   
 Meander  Property   
 Rancho  Other

### COORDINATES(Optional)

N. \_\_\_\_\_  
 E. \_\_\_\_\_  
 Zone \_\_\_\_\_ NAD27  NAD83   
 NAD83 Epoch \_\_\_\_\_  
 Elev. \_\_\_\_\_  
 Vert. Datum: NGVD29  NADV88   
 Meas. Units: Metric  Imperial

Sec. 16, T.1S., R.9E.,  
M.D.B. & M.

Date of Survey April 28, 2014

Corner - Left as found  Found and tagged  Established  Reestablished  Rebuilt

Identification and type of corner found: Evidence used to identify or procedure used to establish or reestablish the corner:

The survey monuments at the witness corners were destroyed by drain canal reconstruction along the southerly side of Parcels "1", "2", "3" and "4" Per (A).

See Sheet 2


A description of the physical condition of the monument as found and as set or reset: \_\_\_\_\_

See Sheet 2

### SURVEYOR'S STATEMENT

This Corner Record was prepared by me or under my direction in conformance with the Land Surveyor's Act on May 5, 2014.

Signed Michael L. Quartaon P.L.S. or R.C.E. No.: \_\_\_\_\_ L.S. 4450

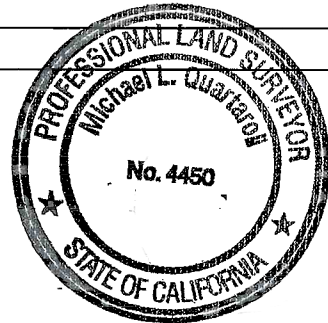


### COUNTY SURVEYOR'S STATEMENT


This Corner Record was received May 7, 2014 and examined and filed June 2, 2014.

Signed Thomas M. Gau P.L.S. or R.C.E. No.: 26994

Title County Surveyor

County Surveyor's Comment \_\_\_\_\_

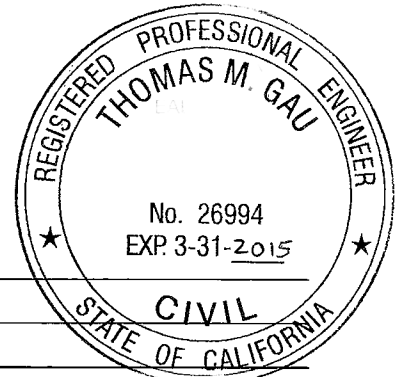

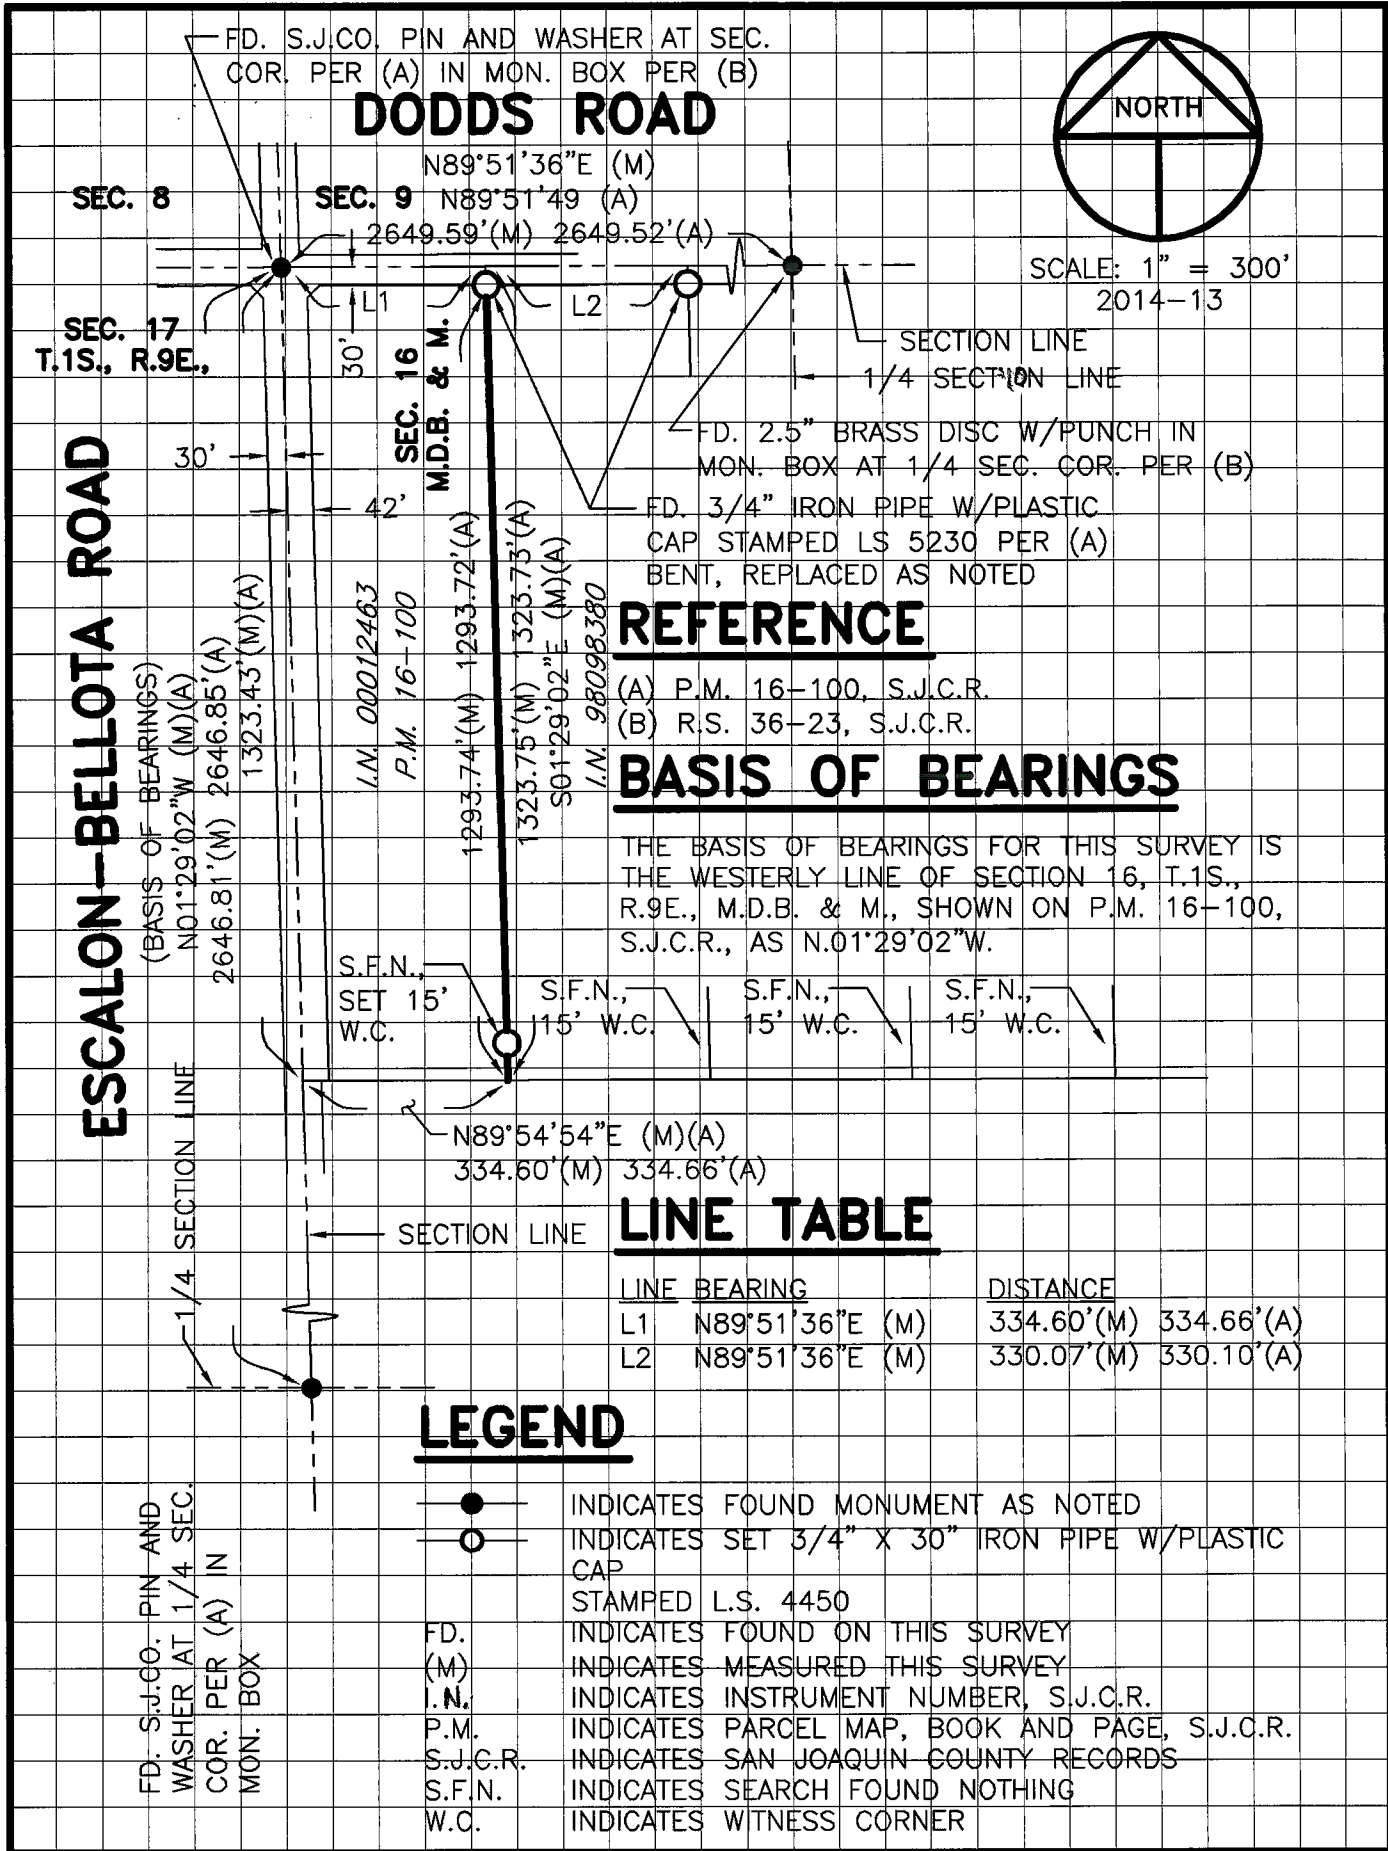

## REFERENCE

- (A) P.M. 16-100, S.J.C.R.
- (B) R.S. 36-23, S.J.C.R.

## BASIS OF BEARINGS

THE BASIS OF BEARINGS FOR THIS SURVEY IS THE WESTERLY LINE OF SECTION 16, T.1S., R.9E., M.D.B. & M., SHOWN ON P.M. 16-100, S.J.C.R., AS N.01°29'02"W.

## LINE TABLE

LINE	BEARING	DISTANCE
L1	N89°51'36"E (M)	334.60'(M) 334.66'(A)
L2	N89°51'36"E (M)	330.07'(M) 330.10'(A)

## LEGEND

- INDICATES FOUND MONUMENT AS NOTED
- INDICATES SET 3/4" X 30" IRON PIPE W/PLASTIC CAP
- STAMPED L.S. 4450
- FD. INDICATES FOUND ON THIS SURVEY
- (M) INDICATES MEASURED THIS SURVEY
- I.N. INDICATES INSTRUMENT NUMBER, S.J.C.R.
- P.M. INDICATES PARCEL MAP, BOOK AND PAGE, S.J.C.R.
- S.J.C.R. INDICATES SAN JOAQUIN COUNTY RECORDS
- S.F.N. INDICATES SEARCH FOUND NOTHING
- W.C. INDICATES WITNESS CORNER