

# CORNER RECORD

Document Number CR-14-150  
 City of STOCKTON County of SAN JOAQUIN, California

Brief Legal Description MONUMENT AT THE INTERSECTION OF ARCH ROAD AND FITE COURT  
LOCATED IN THE EAST HALF OF SECTION 28, T.1N, R.7E, M.D.B.&M.

		CORNER TYPE		COORDINATES (Optional)					
<table border="1"> <tr> <td>NW 1/4</td> <td>NE 1/4</td> </tr> <tr> <td>SW 1/4</td> <td>SE 1/4</td> </tr> </table>	NW 1/4	NE 1/4	SW 1/4	SE 1/4	Government Corner <input type="checkbox"/>	Control <input type="checkbox"/>	N _____		
	NW 1/4	NE 1/4							
	SW 1/4	SE 1/4							
	Meander <input type="checkbox"/>	Property <input type="checkbox"/>	E _____						
Rancho <input type="checkbox"/>	Other <input checked="" type="checkbox"/>	Zone _____ NAD27 <input type="checkbox"/> NAD83 <input type="checkbox"/>							
		NAD83 Epoch _____							
SEC. 28 T.1N, R.7E	Date of Survey <u>5-2-2014</u>	Elev. _____							
		Vert. Datum: NVGD29 <input type="checkbox"/> NVGD88 <input type="checkbox"/>							
		Meas. Units: Metric <input type="checkbox"/> Imperial <input checked="" type="checkbox"/>							

Corner- Left as found  Found and tagged  Established  Reestablished  Rebuilt

Identification and type of corner found: Evidence used to identify or procedure used to establish or reestablish the corner:  
FOUND 3/4" IRON PIN NOT TAGGED IN MONUMENT WELL, AT THE INTERSECTION OF ARCH ROAD AND  
FRONTIERWAY LOCATED IN THE EAST HALF OF SECTION 28, T.1N, R.7E, M.D.B.&M. FOUND MONUMENT AS  
SHOWN ON PARCEL MAP FILED IN BOOK 21 OF PARCEL MAPS AT PAGE 196, SAN JOAQUIN COUNTY  
RECORDS.

A description of the physical condition of the monument as found and as set or reset:  
MONUMENT IS IN AREA OF RECONSTRUCTION, SET TIES AS SHOWN ON PAGE 2.


### SURVEYOR'S STATEMENT

This Corner Record was prepared by me or under my direction in conformance with  
 the Land Surveyors' Act on JUNE 5, 2014,  
 Signed [Signature] P.L.S. or R.C.E. Number 6953



### COUNTY SURVEYOR'S STATEMENT

This Corner Record was received June 17, 2014 and examined  
 and filed August 6, 2014  
 Signed [Signature] P.L.S. or R.C.E. No: 26994  
 Title County Surveyor  
 County Surveyor's Comment \_\_\_\_\_

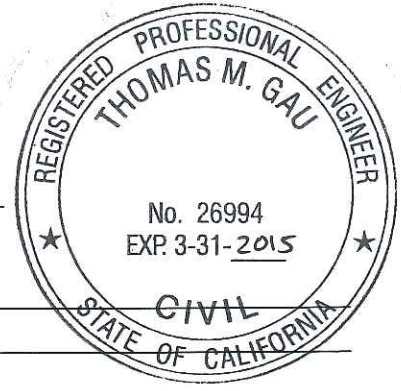

**LEGEND:**

- ⊗ SET MONUMENT AS NOTED
- FOUND MONUMENT AS NOTED.
- S.J.C.R. DENOTES SAN JOAQUIN COUNTY RECORDS
- P.M. DENOTES PARCEL MAP
- (M) MEASURED DISTANCE. ALL DISTANCES ARE MEASURED UNLESS NOTED OTHERWISE.

**REFERENCE:**

(R1) P.M. 21-196, S.J.C.R.

