


**CORNER RECORD**

City of N/A

Document Number 02-27  
County of San Joaquin, California

Brief Legal Description Record of Survey 28-90

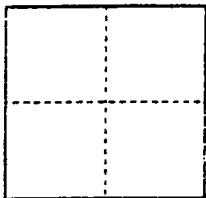

**CORNER TYPE**

- Government Corner  Control
- Meander  Property
- Rancho  Other

Date of Survey July 5, 2001

**COORDINATES (Optional)**

N. \_\_\_\_\_  
 E. \_\_\_\_\_  
 Zone \_\_\_\_\_ NAD27  NAD83   
 NAD83 Epoch \_\_\_\_\_  
 Elev. \_\_\_\_\_  
 Vert. Datum: NGVD29  NAVD88   
 Meas. Units: Metric  Imperial

Corner - Left as found  Found and tagged  Established  Reestablished  Rebuilt

Identification and type of corner found: Evidence used to identify or procedure used to establish or reestablish the corner:


Reset corner as shown in the location indicated on corner record 02-17.

A description of the physical condition of the monument as found and as set or reset: Set 3/4" x 30" iron rod capped and stamped L.S. 7269.

**SURVEYOR'S STATEMENT**

This Corner Record was prepared by me or under my direction in conformance with the Land Surveyors' Act on April 5, 2002.

Signed Joe Murphy L.S. or P.C.E. Number 7269

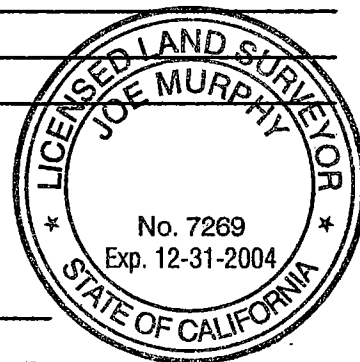

**COUNTY SURVEYOR'S STATEMENT**

This Corner Record was received APRIL 10, 2002 and examined and filed APRIL 17, 2002.

Signed Jeff D. Lund P.L.S. No. 4440

Title Assistant County Surveyor



County Surveyor's Comment \_\_\_\_\_

SET 3/4" I.R.  
 CAPPED L.S. 7269.  
 SET IN PLACE AS SHOWN  
 ON CORNER RECORD 02-17  
 ON FILE WITH THE, SAN JOAQUIN  
 COUNTY SURVEYORS OFFICE

SCALE: N 1" = 300'

SEC. 14

SEC. 13

FD. BOLT AND WASHER  
 IN MONUMENT WELL (R1)  
 AT 1/4 SEC. CORNER,  
 STAMPED "S.J. CO.  
 LS 2239" PER FB 689  
 PG. 78.

N 00°40'44" W 1322.45' (M)

PELTIER RD.

40' R/W

S89°21'23"E 2628.50' (M)  
 2628.56' (R1)

FD R.R. SPIKE (R1)  
 WITH STAMPED CROSS

SEC. 23

SEC. 24

T.4 N., R.6 E.

40' R/W

DES MOINES RD.

REFERENCE

(R1) RS 28-90

LEGEND

- FD FOUND
- I.R. IRON ROD
- R/W RIGHT-OF-WAY
- (M) MEASURED
- MONUMENT FOUND
- RS RECORD OF SURVEY
- S.J. CO. SAN JOAQUIN COUNTY
- MONUMENT SET (AS NOTED)