


CORNER RECORD

City of _____

Document Number 02-29
County of San Joaquin, California

Brief Legal Description Southerly corner of Lot 12, CRAIG TRACT,
1 MAP 20.

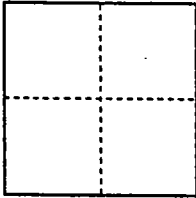

CORNER TYPE

Government Corner Control
Meander Property
Rancho Other

Date of Survey JANUARY 2002

COORDINATES (Optional)

N. _____
E. _____
Zone _____ NAD27 NAD83
NAD83 Epoch _____
Elev. _____
Vert. Datum: NGVD29 NAVD88
Meas. Units: Metric Imperial

Corner - Left as found Found and tagged Established Reestablished Rebuilt

Identification and type of corner found: Evidence used to identify or procedure used to establish or reestablish the corner:

3/4" IRON PIPE, 0.3 METER BELOW ROAD SURFACE,
UNDER 0.2 METER OF PAVEMENT. FOUND BY RETRACING
COUNTY SURVEY ALONG NEWTON ROAD. SEE COUNTY FIELD
BOOK 619, PAGES 62 & 63. RECENT SURVEY ALONG
CHEROKEE ROAD WAS PERFORMED TO CONFIRM PIPE IS AT CORNER.

A description of the physical condition of the monument as found and as set or reset:

SEE SKETCH ON BACK

SURVEYOR'S STATEMENT

This Corner Record was prepared by me or under my direction in conformance with
the Land Surveyors' Act on MAY 13th, 2002.

Signed Daniel H. Thorpe L.S. or R.C.E. Number 6455




COUNTY SURVEYOR'S STATEMENT

This Corner Record was received MAY 21, 2002 and examined
and filed MAY 31, 2002.

Signed Jeff Lund L.S. No. 4440

Title ASSISTANT County Surveyor

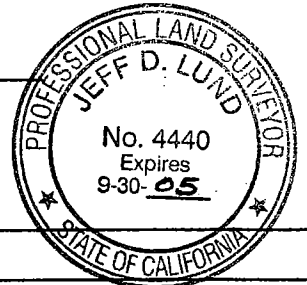

County Surveyor's Comment _____

(D.D. Sheet No. 32A)

29 R/S 172
 4 December 1987



No Scale

Legend

- M&P Maps and Plats
- R/S Record of Survey
- O.R. Official Records
- monument as noted

Set 1" Iron Pipe
 with yellow plastic
 plug "MTCO LS6455"

0.404m
 N23°01'W

Set 3" long survey
 marker nail with
 washer stamped
 "MTCO LS6455"
 inside found
 3/4" Iron Pipe

Found
 City of Stockton
 Brass Disk
 "14S-4 LS6670"
 in monument box

Lot 12
 Craig Tract
 1 M&P 20
 17 April 1897

Lot 14

Newton
 Road

Cherokee
 Road

N17°00'11"W

N32°37'12"E

24.383m
 (80')

24.383m
 (80')

3700 O.R. 362

3700 O.R. 359

3625 O.R. 599

32.896m
 N34°36'18"E

N3°53'31"E
 25.135m

BEARINGS AND DISTANCES SHOWN ARE BASED ON THE CALIFORNIA COORDINATE SYSTEM OF 1983, ZONE 3. DISTANCES ARE IN METERS UNLESS OTHERWISE NOTED. MULTIPLY DISTANCES SHOWN BY 1.00006 TO OBTAIN GROUND LEVEL DISTANCES. TO CONVERT METERS TO THE U.S. SURVEY FOOT, MULTIPLY DISTANCES BY 3937/1200.