


**CORNER RECORD**

City of Stockton

Document Number 02-30  
County of San Joaquin, California

Brief Legal Description Lot 5, Hacienda Village, M&P 19-33, S.J.C.R.

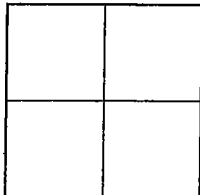

**CORNER TYPE**

- Government Corner  Control
- Meander  Property
- Rancho  Other

Date of Survey March 12, 2002

**COORDINATES (Optional)**

N. \_\_\_\_\_  
 E. \_\_\_\_\_  
 Zone                      NAD27  NAD83   
 NAD83 Epoch                       
 Elev. \_\_\_\_\_  
 Vert. Datum: NGVD29  NAVD88   
 Meas. Units: Metric  Imperial

**Corner -** Left as found  Found and tagged  Established  Reestablished  Rebuilt

Identification and type of corner found: Evidence used to identify or procedure used to establish or reestablish the corner:  
Found chiseled crosses at lot corners consistent with record data as shown on M&P 19-33.


The record map shows 3/4" iron pipes set at the lot corners but were not found during our survey.

A description of the physical condition of the monument as found and as set or reset: The physical condition of the crosses was good. No accessory monumentation was set during our retracement survey.

**SURVEYOR'S STATEMENT**

This Corner Record was prepared by me or under my direction in conformance with the Land Surveyors' Act on April 30, 2002.

Signed Stephen R. Thumbert L.S. or R.C.E. Number 4334

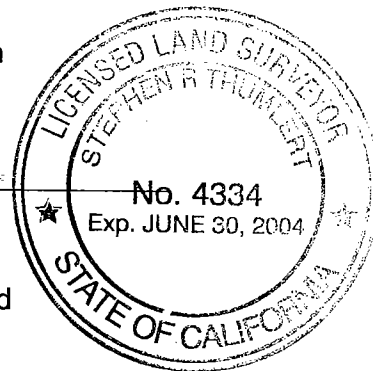


**COUNTY SURVEYOR'S STATEMENT**


This Corner Record was received MAY 29, 2002 and examined and filed JUNE 7, 2002.

Signed Jeff D. Lund P.L.S. No. 4440

Title Assistant County Surveyor

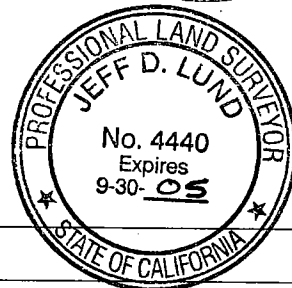

County Surveyor's Comment \_\_\_\_\_

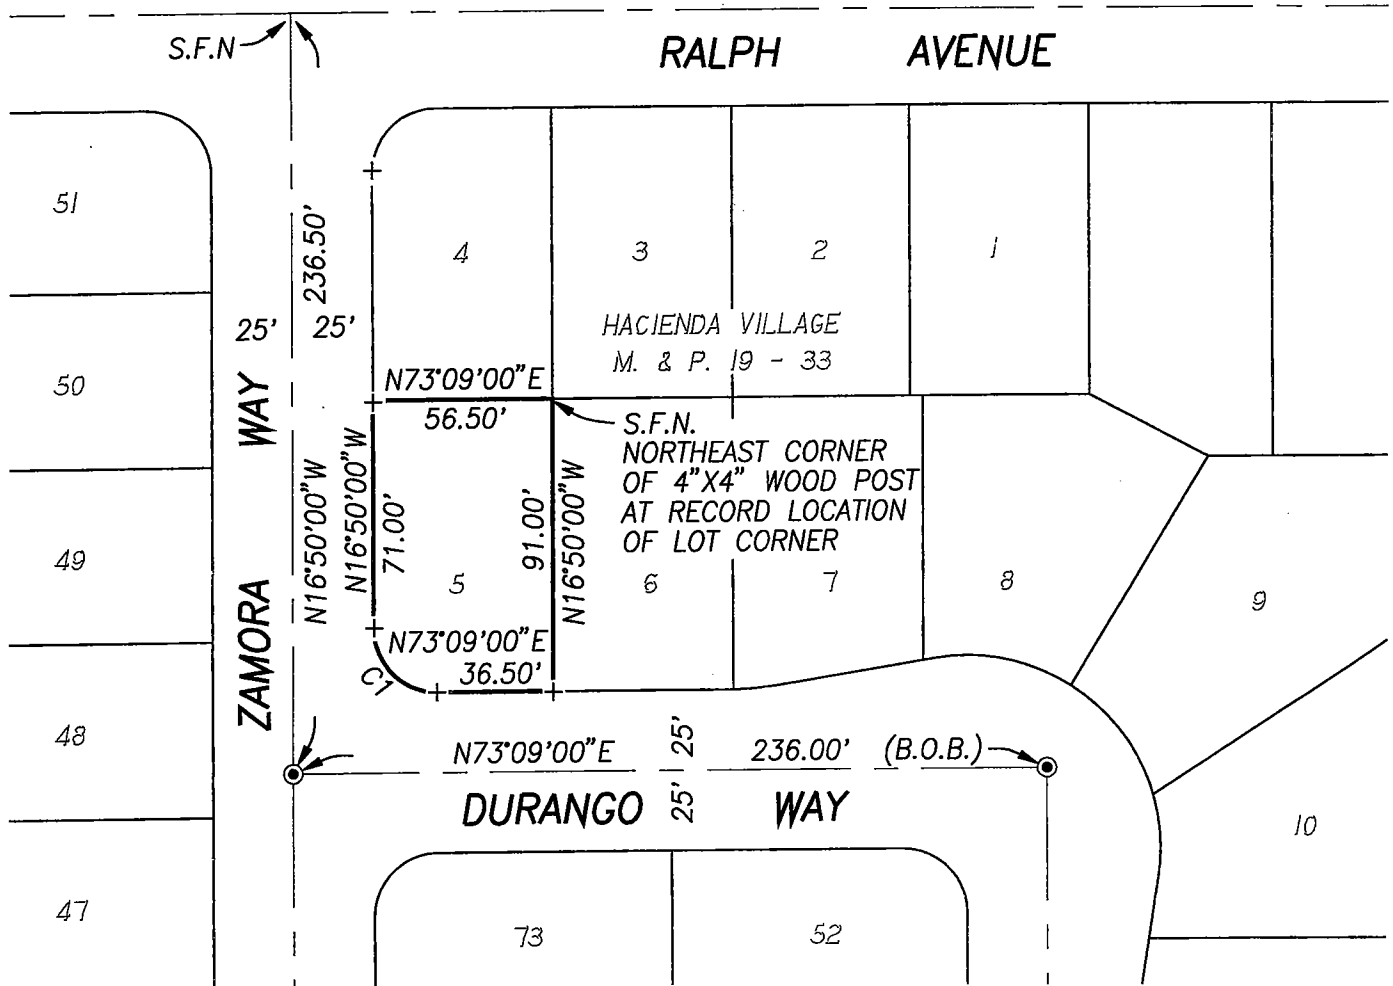

RECORD CURVE DATA

| CURVE | RADIUS | DELTA     | LENGTH | CHORD              |
|-------|--------|-----------|--------|--------------------|
| C1    | 20.00' | 90°01'00" | 31.41' | S61°50'30"E 28.28' |

SCALE: 1" = 60'

LEGEND:

- + — SEARCHED FOR 3/4" IRON PIPE TAGGED "RCE 9924" PER PER M. & P. 19-33, S.J.C.R., FOUND CHISELED " + " , (NO REC.)
- ● — FD 3/4" IRON PIPE TAGGED "RCE 9924" IN MONUMENT BOX PER M. & P. 19-33, S.J.C.R.
- S.F.N. SEARCHED, FOUND NOTHING
- (B.O.B.) BASIS OF BEARINGS
- M. & P. MAPS AND PLATS
- S.J.C.R. SAN JOAQUIN COUNTY RECORDS