


CORNER RECORD

City of RIPON

Document Number 02-42
County of San Joaquin, California

Brief Legal Description Property corner located in the NW 1/4
of Sec. 29, T.2S., R.8E., M.D.B. & M. and shown on R.S. 34-2.

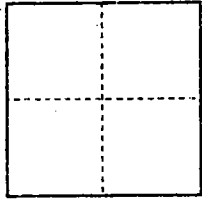

CORNER TYPE

- Government Corner Control
- Meander Property
- Rancho Other

Date of Survey August 13, 2002

COORDINATES (Optional)

N. _____
 E. _____
 Zone _____ NAD27 NAD83
 NAD83 Epoch _____
 Elev. _____
 Vert. Datum: NGVD29 NAVD88
 Meas. Units: Metric Imperial

Corner - Left as found Found and tagged Established Reestablished Rebuilt


Identification and type of corner found: Evidence used to identify or procedure used to establish or reestablish the corner:
Reestablished the property corner by measuring the record
distance from found property corners as shown on the record
map filed November 7, 1997, in Book 34 of Surveys, at Page 2,
San Joaquin County Records. (see drawing on back)

A description of the physical condition of the monument as found and as set or reset:
Found the remains of iron pipe tagged L.S.3870, near concrete
base for light post. Reset 24" long, 3/4" diameter iron pipe,
with brass tag L.S. 5190.

SURVEYOR'S STATEMENT

This Corner Record was prepared by me or under my direction in conformance with the Land Surveyors' Act on August 15, 2002.

Signed David R. Souza L.S. ~~5190~~ Number 5190

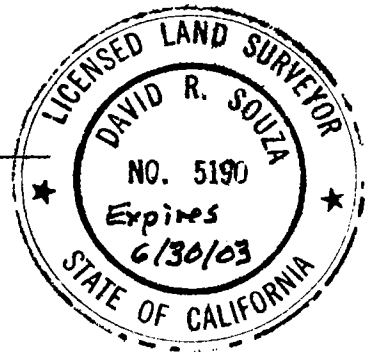

COUNTY SURVEYOR'S STATEMENT

This Corner Record was received SEPTEMBER 18, 2002 and examined and filed SEPTEMBER 23, 2002.

Signed Jeff Lund P.L.S. No. 4440
Title Assistant County Surveyor



County Surveyor's Comment _____

FOURTH STREET

CORNER RECORD
BK. 34 OF SURVEYS, AT PG. 2
SAN JOAQUIN COUNTY.
PORTION OF LOT 29 & 30
OF KOCH'S TRACT,
NW. 1/4, SEC. 29, T.2 S., R.8 E.
M.D.B. & M.
CITY OF RIFON



NO SCALE

REFERENCES/LEGEND:

- (M) MEASURED DISTANCE
- (R) SURVEYS, BK. 34, PG. 2
- (I.P.) IRON PIPE

STOCKTON AVE.

FIFTH STREET

759.75' (M & R)

FOUND 3/4" I.P. TAGGED L.S.
3870, AS PER MAP,
BK. 34 SURVEYS, PG. 2,
SAN JOAQUIN COUNTY RECORDS.

332.90' (M & R)

SET 24" LONG 3/4" I.P.
TAGGED L.S. 5190

M.I.D. SUB-STA.

S.S.J.I.D. "U" CANAL