


CORNER RECORD

City of Lodi

Document Number 02-54
County of San Joaquin, California

Brief Legal Description Lower Sacramento Road at Oxford Way

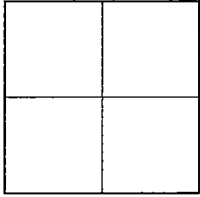

CORNER TYPE

Government Corner Control
Meander Property
Rancho Other

Date of Survey 8/8/99

COORDINATES (Optional)

N. _____
E. _____
Zone _____ NAD27 NAD83
NAD83 Epoch _____
Elev. _____
Vert. Datum: NGVD29 NAVD88
Meas. Units: Metric Imperial

Corner - Left as found Found and tagged Established Reestablished Rebuilt


Identification and type of corner found: Evidence used to identify or procedure used to establish or reestablish the corner:
Found 3/4 inch iron rod, tagged LS2273, in monument box at the intersection of Lower Sacramento Road and Oxford Way per Maps and Plats 18-42.

A description of the physical condition of the monument as found and as set or reset: The monument is in good condition. Reference point was set in case monument is disturbed.

SURVEYOR'S STATEMENT

This Corner Record was prepared by me or under my direction in conformance with the Land Surveyors' Act on November 15, 2002.

Signed Terry Piazza L.S. or R.C.E. Number 19638

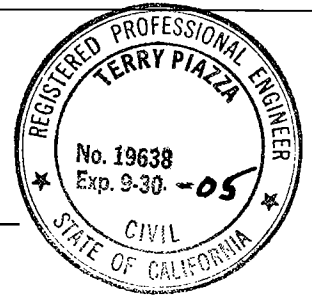

COUNTY SURVEYOR'S STATEMENT

This Corner Record was received DECEMBER 27, 2002 and examined and filed JANUARY 3, 2003.

Signed Jeff D. Lund P.L.S. No. 4440

Title Assistant County Surveyor




County Surveyor's Comment This corner record is not in compliance with Board Rule 464(c) regarding submittal within 90 days from the date of survey.

(D.D. Sheet No. 15-A)



NOT TO SCALE

LOWER SACRAMENTO ROAD

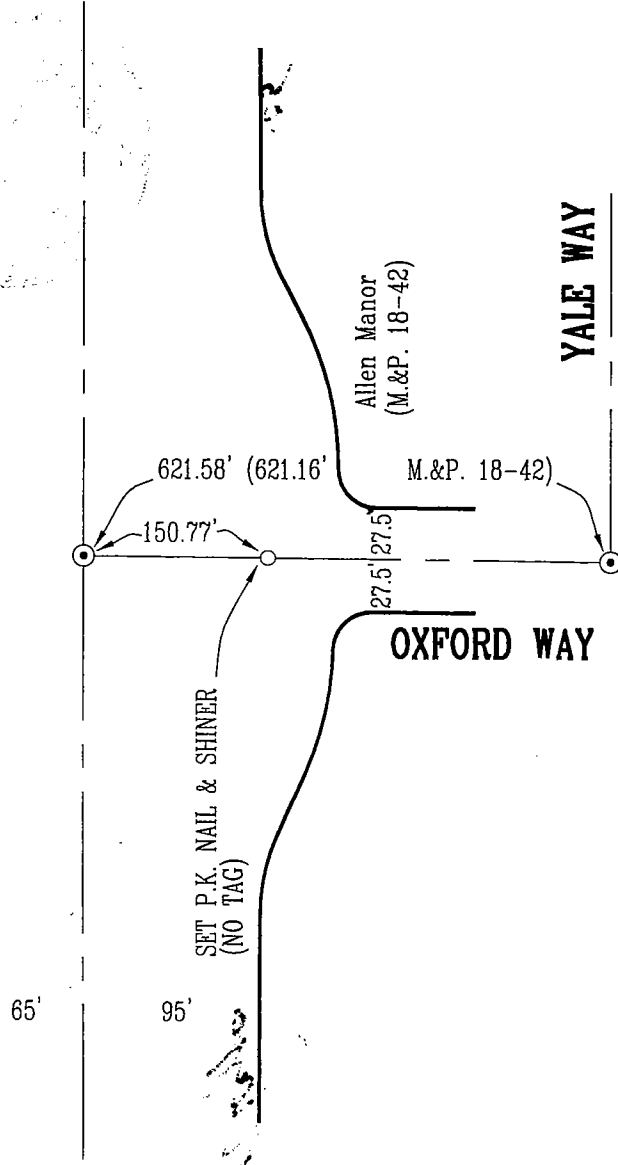

LEGEND

SEC.	SECTION
FD.	FOUND
○	SET MONUMENT, AS NOTED
⊙	FD. 3/4" IRON ROD TAGGED L.S. 2273 IN MONUMENT BOX PER M.&P. 18-42
M.&P.	BOOK OF MAPS AND PLATS

ALL REFERENCES ARE TO SAN JOAQUIN COUNTY RECORDS AND BOOK OR VOLUME PRECEDES PAGE.

NOTE:

THE TIES SHOWN HEREON ARE FOR THE PURPOSE OF PERPETUATING THE MONUMENTATION CURRENTLY EXISTING. NO ATTEMPT WAS MADE TO DETERMINE THE VALIDITY OF THE MONUMENTS OR THEIR PROPER LOCATION IN RELATION TO LEGAL BOUNDARY LINES IN THE AREA.

10/16/23