


**CORNER RECORD**

City of \_\_\_\_\_ Document Number 03-03  
County of San Joaquin, California

Brief Legal Description Angle point in Westerly line of Parcel 1 per Record of Survey Book 21, Page 75, San Joaquin County Records.

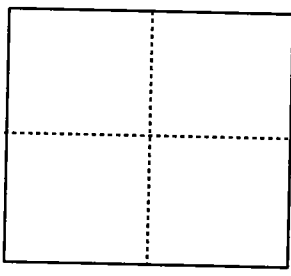

**CORNER TYPE**

- Government Corner  Control
- Meander  Property
- Rancho  Other

Date of Survey December 11, 2002

**COORDINATES (Optional)**

N. \_\_\_\_\_  
 E. \_\_\_\_\_  
 Zone \_\_\_\_\_ NAD27  NAD83   
 NAD83 Epoch \_\_\_\_\_  
 Elev. \_\_\_\_\_  
 Vert. Datum: NGVD29  NAVD88   
 Meas. Units: Metric  Imperial

Corner - Left as found  Found and tagged  Established  Reestablished  Rebuilt

Identification and type of corner found: Evidence used to identify or procedure used to establish or reestablish the corner:  
Found 3/4" Iron Pipe Tagged R.C.E. 6152 per Record of Survey Book 21, Page 75, San Joaquin County Records.

A description of the physical condition of the monument as found and as set or reset: \_\_\_\_\_  
● Indicates Found Monument as noted.

**SURVEYOR'S STATEMENT**

This Corner Record was prepared by me or under my direction in conformance with the Land Surveyor's Act on December 26, 2002.

Signed Michael L. Quartaroli L.S. Number 4450




**COUNTY SURVEYOR'S STATEMENT**

This Corner Record was received JANUARY 16, 2003 and examined and filed JANUARY 22, 2003.

Signed [Signature] L.S. R.C.E. Number 4440

Title Asst. County Surveyor

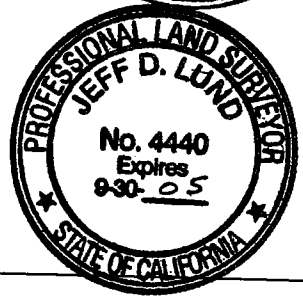

County Surveyor's Comment \_\_\_\_\_

# LEGEND

- FD. INDICATES FOUND ON THIS SURVEY
- S.F.N. INDICATES SEARCHED, FOUND NOTHING
- R.S. INDICATES RECORD OF SURVEY, BOOK AND PAGE, S.J.C.R.
- S.J.C.R. INDICATES SAN JOAQUIN COUNTY RECORDS
- (M) INDICATES MEASURED

# BASIS OF BEARINGS

THE BEARING BETWEEN THE SW CORNER OF SECTION 12, T.2S., R.9E., M.D.B.& M. AND THE SE CORNER OF PARCEL 3 OF R.S. 21-75, S.J.C.R., BEARS N 48°04'49" E CALCULATED FROM R.S. 21-75, S.J.C.R.

