


CORNER RECORD

City of RIPON Document Number 03-42
 County of SAN JOAQUIN, California
 Brief Legal Description CENTERLINES - JOHN ROOS AVE / BOESCH DRIVE

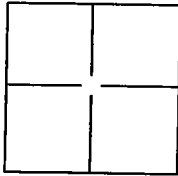

CORNER TYPE

Government Corner Control
 Meander Property
 Rancho Other

Date of Survey 3-26-03

COORDINATES(Optional)

N. _____
 E. _____
 Zone _____ NAD27 NAD83
 NAD83 Epoch _____
 Elevation _____
 Vert. Datum: NGVD29 NAV88
 Meas. Units: Metric Imperial

Corner - Left as found Found and tagged Established Reestablished Rebuilt

Identification and type of corner found: Evidence used to identify or procedure used to establish or reestablish the corner:

Set 3/4" iron pipe tagged LS 3863 in monument well

A description of the physical condition of the monument as found and as set or reset:


See sketch on Backside

SURVEYOR'S STATEMENT

This Corner Record was prepared by me or under my direction in conformance with

the Land Surveyor's Act on March 26, 2003.

Signed Wayne G. Sutton P.L.S. or R.C.E. Number 3863

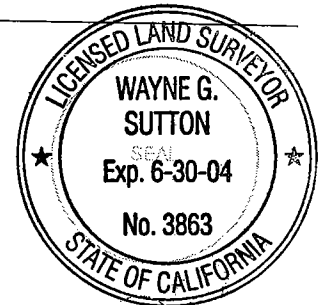

COUNTY SURVEYOR'S STATEMENT

This Corner Record was received MAY 13, 2003 and examined

and filed MAY 16, 2003.

Signed [Signature] P.L.S. or R.C.E. Number 4440

Title ASSISTANT COUNTY SURVEYOR

County Surveyor's Comment _____



D.P. SHEET NO. 60

