


CORNER RECORD

Document Number 06-25
 City of TRACY County of SAN JOAQUIN, California
 Brief Legal Description SITUATE IN THE SOUTHEAST QUARTER OF SECTION 19, T.2 S., R. 5 E.,
M.B.D.&M.

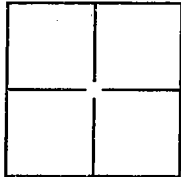

CORNER TYPE

Government Corner Control
 Meander Property
 Rancho Other

Date of Survey AUG. 24, 2006

COORDINATES (Optional)

N _____
 E _____
 Zone _____ NAD27 NAD83
 NAD83 Epoch _____
 Elevation _____
 Vert. Datum: NVGD29 NVGD88
 Meas Units: Metric Imperial

Corner— Left as found Found and tagged Established Reestablished Rebuilt


Identification and type of corner found: Evidence used to identify or procedure used to establish or reestablish the corner.
FOUND SCRIBED "+" IN CONCRETE SIDEWALK AS SHOWN ON THE MAP OF TRACT No. 3467
"SUBDIVISIONS OF SAN JOAQUIN COUNTY MEADOWOOD IV" FILED IN
BOOK 40 OF MAPS AND PLATS, AT PAGE 61, S.J.C.R. SET AS A 5.5 FOOT WITNESS
CORNER TO THE SOUTHEAST CORNER OF LOT 8 SHOWN ON BOOK 40 OF MAPS AND PLATS,
PAGE 61, S.J.C.R.

A description of the physical condition of the monument as found and as set or reset:
FOUND SCRIBED "+" IN CONCRETE SIDEWALK AS SHOWN ON THE MAP OF TRACT No. 3467
"SUBDIVISIONS OF SAN JOAQUIN COUNTY MEADOWOOD IV" FILED IN
BOOK 40 OF MAPS AND PLATS, AT PAGE 61, S.J.C.R. SET WITNESS TIES AS SHOWN ON
DIAGRAM DRAWN ON PAGE 2 OF 2 HEREON.

SURVEYOR'S STATEMENT

This Corner Record was prepared by me or under my direction in conformance with
 the Land Surveyor's Act on SEPTEMBER 18, 2006.

Signed _____ P.L.S. or R.C.E. Number LS 6805

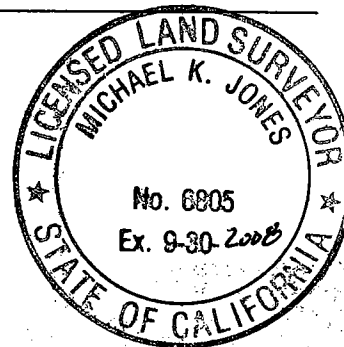

COUNTY SURVEYOR'S STATEMENT

This Corner Record was received SEPTEMBER 29, 2006 and examined
 and filed OCTOBER 4, 2006.

Signed J. J. Lund P.L.S. or R.C.E. Number 4440

Title ASSISTANT COUNTY SURVEYOR

County Surveyor's Comment _____

