


**CORNER RECORD**

City of Lodi

Document Number CR-17-01  
County of San Joaquin, California

Brief Legal Description Cherokee Lane and Harold Street,  
within Northeast Quarter of Section 12, T3N, R6E

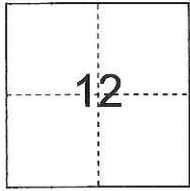

**CORNER TYPE**

Government Corner  Control   
Meander  Property   
Rancho  Other   
Date of Survey Nov. 16, 2016

**COORDINATES (Optional)**

N. \_\_\_\_\_  
E. \_\_\_\_\_  
Zone \_\_\_\_\_ NAD27  NAD83   
NAD83 Epoch \_\_\_\_\_  
Elev. \_\_\_\_\_  
Vert. Datum: NGVD29  NAVD88   
Meas. Units: Metric  Imperial

Corner - Left as found  Found and tagged  Established  Reestablished  Rebuilt

Identification and type of corner found: Evidence used to identify or procedure used to establish or reestablish the corner:  
See sketch on backside.

A description of the physical condition of the monument as found and as set or reset:  
See sketch on backside.

**SURVEYOR'S STATEMENT**

This Corner Record was prepared by me or under my direction in conformance with  
the Land Surveyors' Act on Nov. 30, 2016

Signed [Signature] (L.S.) or R.C.E. Number 7889



**COUNTY SURVEYOR'S STATEMENT**

This Corner Record was received December 1, 2016, and examined  
and filed January 10, 2017


Signed Warren D. Smith P.L.S. No. 4842  
Title County Surveyor



County Surveyor's Comment \_\_\_\_\_

(D.D. Sheet No. 16 )

S:\Projects\2016\1009\18\_Drawings\1009A\_Drawings\1009A\_001.dwg 12/01/16 9:25am-10:50P-102P5 19709\_001.dwg 001\_Control Network and BP\_Local.dwg 001\_Shape File.dwg 001\_BP\_P.dwg

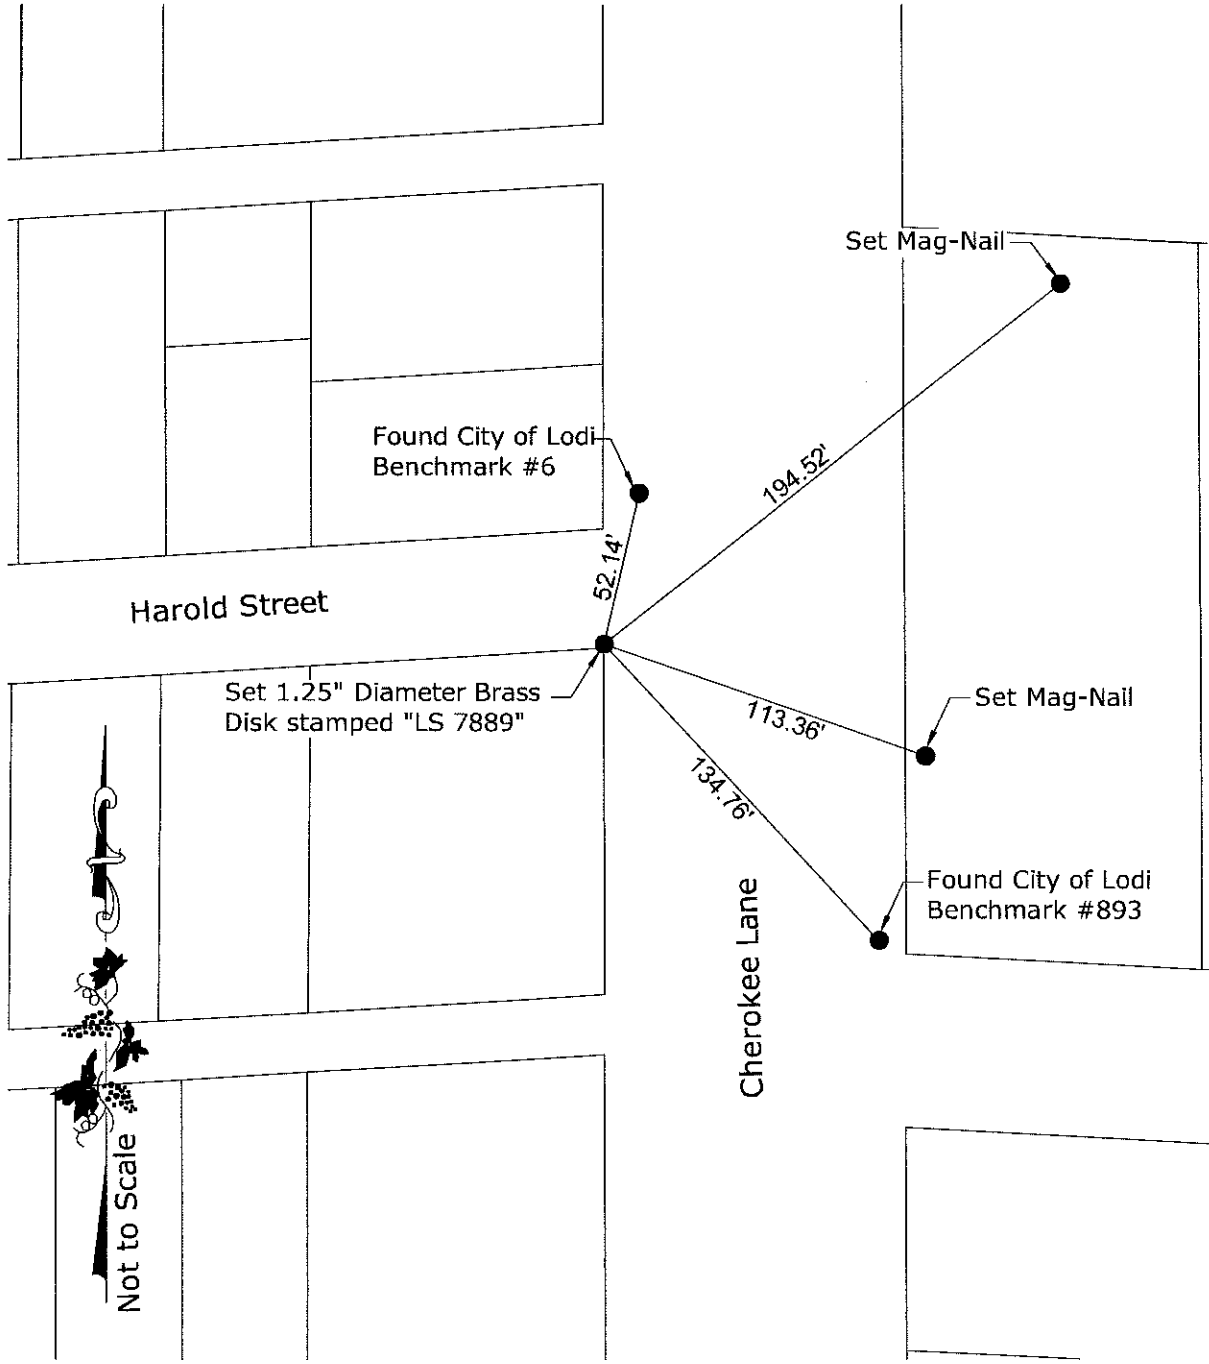

Notes:

- 1. Monuments are not tagged unless noted.
- 2. No attempt was made to verify the monument(s)



PREPARED IN THE OFFICE OF:

**BAUMBACH & PIAZZA, INC.**

CIVIL ENGINEERS • SURVEYORS

www.bpengineers.net

209.368.6618

323 W. Elm St.

Lodi, CA 95240