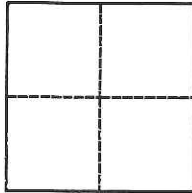


# CORNER RECORD

Agency Index CR-17-132

Document Number \_\_\_\_\_

City of Tracy County of San Joaquin, CaliforniaBrief Legal Description Monument Northeastly Corner of Lot 24 per 10-M-44.**CORNER TYPE****COORDINATES (Optional)**

Government Corner  Control  Elevation  
 Meander  Property  Units  
 Rancho  Other  Horizontal Datum

N. \_\_\_\_\_ E. \_\_\_\_\_

Elevation \_\_\_\_\_

Units Metric  U.S. Survey Foot 

Horizontal Datum \_\_\_\_\_

Zone \_\_\_\_\_ Epoch Date \_\_\_\_\_

Date of Survey March 31, 2017

Vertical Datum \_\_\_\_\_

 Complies with Public Resources Code §§8801-8819 Complies with Public Resources Code §§8890-8902

PLS Act Ref.:

 8765(d) 8771 8773 Other:Corner/  
Monument: Left as found Established Rebuilt Pre-Construction Found and tagged Reestablished Referenced Post-Construction

Narrative of corner identified and monument as found, set, reset, replaced, or removed:

 See sheet #2 for description(s):

Found Iron Rod in pavement.

**SURVEYOR'S STATEMENT**


This Corner Record was prepared by me or under my direction in conformance with

the Professional Land Surveyors' Act on April 3, 2017

Signed

Richard J. Hickenbottom

P.L.S. or R.C.E. No.

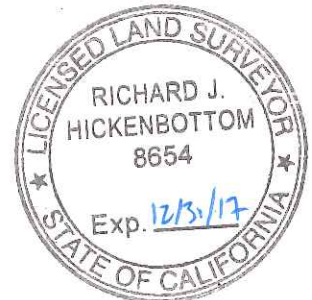8654**COUNTY SURVEYOR'S STATEMENT**

This Corner Record was received

April 17, 2017

and examined and filed

May 18, 2017

Signed

Warren D. Smith

P.L.S. or R.C.E. No.

4842

Title

County Surveyor

County Surveyor's Comment





**LEGEND**

- ⊗ SET NAIL W/ TAG "LS8654"
- SET IRON PIPE W/ PLUG "LS8654"
- ⊙ MONUMENT
- PP POWER POLE
- SFNF SEARCHED FOR NOT FOUND
- TB TELEPHONE BOX
- EDGE OF PAVEMENT
- CENTERLINE
- BOUNDARY LINE
- MONUMENT TIE LINE
- TOP OF BANK

**LOT 24**  
 MAP OF UNIT NO. 1  
 PESCADERO COLONY  
 10 M 44

**LOT 37**  
 MAP OF UNIT NO. 1  
 PESCADERO COLONY  
 10 M 44

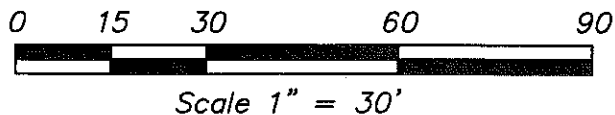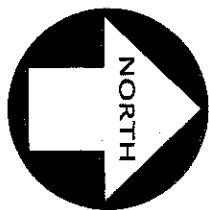

SFNF  
 NORTHWESTERLY  
 CORNER LOT 24  
 PER 10 M 44

FOUND IRON ROD  
 NORTHEASTERLY  
 CORNER LOT 24  
 PER 10 M 44


SFNF  
 NORTHEASTERLY  
 CORNER LOT 37  
 PER 10 M 44

**ARBOR AVENUE**

DITCH

DITCH

PP

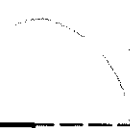

DITCH

DITCH

