

1" = 50'

○ Indicates 3/4" iron pipe found-Set L.S. 3240 Tag

Bearings & Distances are record & measured per M. & P. 1/68

SURVEYOR'S CERTIFICATE

THIS CORNER RECORD WAS PREPARED BY ME OR UNDER MY DIRECTION IN CONFORMANCE WITH THE LAND SURVEYORS ACT ON DECEMBER 12,

J. Ronald White

No. 3240 S. NO.: 3240

SURVEYOR'S STATEMENT: \_\_\_\_\_


COUNTY SURVEYOR'S CERTIFICATE

THIS CORNER RECORD WAS RECEIVED March 7, 19 90

AND EXAMINED AND FILED March 8, 19 90

BY: Robert M. Debraamok

TITLE: Chief Deputy County Surveyor

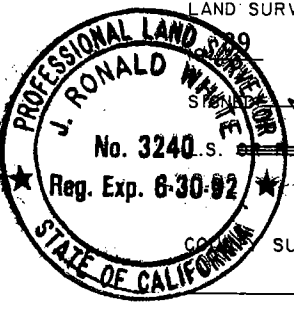

DOCUMENT NO. CR-90-001

THIS FORM PREPARED BY THE LEAGUE OF CALIFORNIA SURVEYING ORGANIZATIONS, SOUTHERN REGION