


CORNER RECORD

Document Number CR-91-007

City of STOCKTON County of SAN JOAQUIN, California

Brief Legal Description RIGHT OF WAY CORNER COMMON TO ST. RTE. 4 AND LAFAYETTE ST.

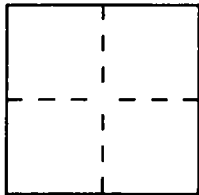

CORNER TYPE

Government Corner Control
Meander Property
Rancho Other
Date of Survey 10-23-91

**COORDINATES
(Optional)**

N. _____
E. _____
Zone _____ Datum _____
Elev. _____

Corner — Left as found Found and tagged Established Reestablished Rebuilt


Identification and type of corner found: Evidence used to identify or procedure used to establish or reestablish the corner: FOUND 3/4" IRON PIN, NO TAG, DOWN 0' SEE 17-S-19

A description of the physical condition of the monument as found and as set or reset: MONUMENT IS IN GOOD CONDITION AND IS PROTECTED BY CHAIN LINK RIGHT OF WAY FENCE.

SURVEYOR'S STATEMENT

This Corner Record was prepared by me or under my direction in conformance with the Land Surveyors' Act on Oct 23 19 91.

Signed Ralph Scheel, Jr. L.S. or R.C.E. Number L53730

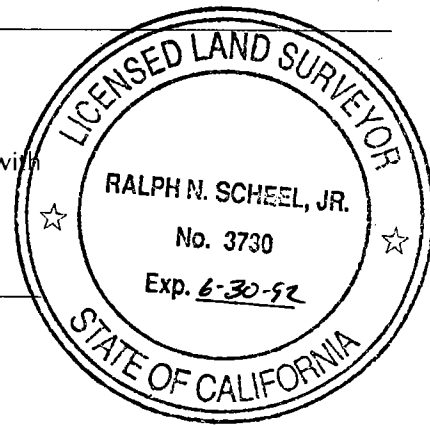

COUNTY SURVEYOR'S STATEMENT

This Corner Record was received December 16, 19 91 and examined and filed December 23, 19 91.

Signed Paul Dehmanek Title Chief Deputy County Surveyor

County Surveyor's Comment _____

FLOWLINE OF GUTTER

LAFAY SET ANCHOR IN EXPANSION JOINTS AT EDGE OF WALK

2.06'
FEL. 3/8" IRON PIN
NO TAG, DOWN 0'
17919

STREET

RENDON AVE

POINT LIES APPROXIMATELY 37' EASTERLY OF CENTERLINE OF RENDON AVENUE.