


CORNER RECORD

Document Number CR-91-008

City of STOCKTON County of SAN JOAQUIN, California

Brief Legal Description INTERSECTION OF NORTH RIGHT OF WAY, LAFAYETTE WITH S. RIGHT OF WAY STATE ROUTE 4

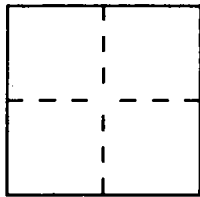

CORNER TYPE

Government Corner Control
Meander Property
Rancho Other
Date of Survey 10-23-91

COORDINATES (Optional)

N. _____
E. _____
Zone _____ Datum _____
Elev. _____

Corner — Left as found Found and tagged Established Reestablished Rebuilt


Identification and type of corner found: Evidence used to identify or procedure used to establish or reestablish the corner: FOUND 3/4" I. PIN, DOWN 0.8, NO TAG, SEE 17-S-35

A description of the physical condition of the monument as found and as set or reset: MONUMENT IS IN GOOD CONDITION AND RIGHT OF WAY FENCE HAS BEEN BUILT, MON. IS 2.11 FEET FROM CORNER POST.

SURVEYOR'S STATEMENT

This Corner Record was prepared by me or under my direction in conformance with the Land Surveyors' Act on Oct. 23 19 91.

Signed Ralph Scheel, Jr. L.S. or R.C.E. Number L53730
Exp 6-30-92

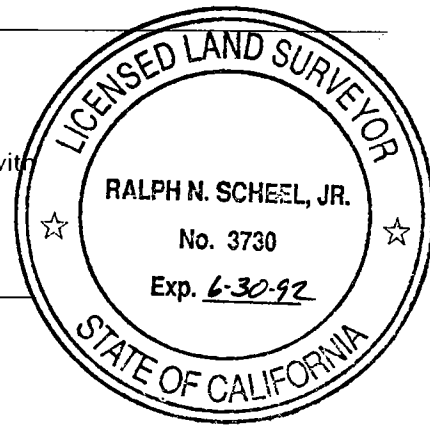

COUNTY SURVEYOR'S STATEMENT

This Corner Record was received December 14, 19 91 and examined and filed December 23, 19 91.

Signed Robert Dehmanek Title Chief Deputy County Surveyor

County Surveyor's Comment _____

13.11 2.11
13.46

