


CORNER RECORD

Document Number CR-91-009

City of STOCKTON County of SAN JOAQUIN, California

Brief Legal Description REFERENCE TO PROPERTY CORNER AT S.E. COR. MARKET & 'F' ST.

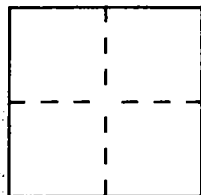

CORNER TYPE

Government Corner Control
 Meander Property
 Rancho Other
 Date of Survey 10-23-91

COORDINATES (Optional)

N. _____
 E. _____
 Zone _____ Datum _____
 Elev. _____

Corner — Left as found Found and tagged Established Reestablished Rebuilt


Identification and type of corner found: Evidence used to identify or procedure used to establish or reestablish the corner: + IN CONCRETE WALK, REFERENCE TO PROPERTY CORNER
NO REFERENCES FOUND

A description of the physical condition of the monument as found and as set or reset: + IN GOOD CONDITION
IN WHEEL CHAIR RAMP.

SURVEYOR'S STATEMENT

This Corner Record was prepared by me or under my direction in conformance with the Land Surveyors' Act on Oct. 23 1991.

Signed Ralph Scheel, Jr. L.S. or R.C.E. Number LS 3730
Exp 6-30-92

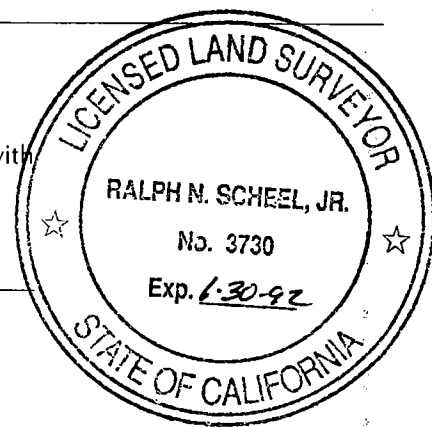

COUNTY SURVEYOR'S STATEMENT

This Corner Record was received December 16, 1991 and examined and filed December 23, 1991.

Signed Robert S. DeLamark Title Chief Deputy County Surveyor

County Surveyor's Comment _____

ST. RTE. 4

MARKET ST

FOUND + ON WALK
NO REFERENCES
FOUND

17.1' STREET

13.00

51.42

60.25

SET PK IN EXPANSION
JOINT 2.9' FROM
BACK OF WALK

SET PK IN EXPANSION
JOINT 3' FROM BACK
OF WALK

SET PK IN EXPANSION
JOINT 2.95 FROM BACK
EDGE OF WALK