


CORNER RECORD

Document Number CR-91-011

City of STOCKTON

County of SAN JOAQUIN, California

Brief Legal Description CITY MON. NEAR INTERSECTION OF DELLA & WASHINGTON ST.

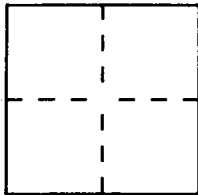

CORNER TYPE

Government Corner Control
 Meander Property
 Rancho Other
 Date of Survey 10-23-91

COORDINATES (Optional)

N. _____
 E. _____
 Zone _____ Datum _____
 Elev. _____

Corner — Left as found Found and tagged Established Reestablished Rebuilt


Identification and type of corner found: Evidence used to identify or procedure used to establish or reestablish the corner: 1/4" IRON PIN IN MONUMENT BOX, CITY MONUMENT.

A description of the physical condition of the monument as found and as set or reset: MONUMENT IN GOOD CONDITION.

SURVEYOR'S STATEMENT

This Corner Record was prepared by me or under my direction in conformance with the Land Surveyors' Act on Oct. 23 19 91.

Signed Ralph Scheel, Jr. L.S. or R.C.E. Number LS 3730
EXP 6-30-92

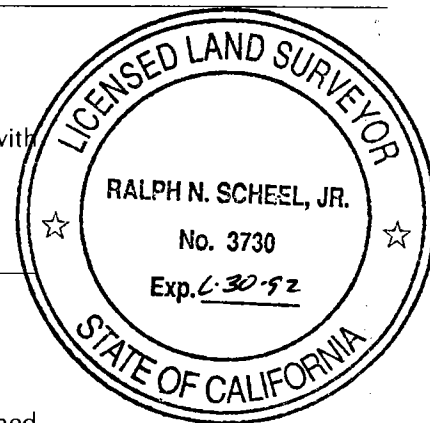

COUNTY SURVEYOR'S STATEMENT

This Corner Record was received December 16, 19 91 and examined and filed December 23, 19 91.

Signed Robert Debraumek Title Chief Deputy County Surveyor

County Surveyor's Comment _____

