


**CORNER RECORD**

Document Number CR-91-013

City of STOCKTON

County of SAN JOAQUIN, California

Brief Legal Description PROPERTY CORNER & REFERENCE AT N.E. CORNER WILSON & WASHINGTON ST

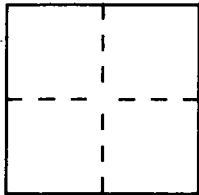

**CORNER TYPE**

**COORDINATES  
(Optional)**

Government Corner  Control   
Meander  Property   
Rancho  Other   
Date of Survey 10-23-91

N. \_\_\_\_\_  
E. \_\_\_\_\_  
Zone \_\_\_\_\_ Datum \_\_\_\_\_  
Elev. \_\_\_\_\_

Corner — Left as found  Found and tagged  Established  Reestablished  Rebuilt


Identification and type of corner found: Evidence used to identify or procedure used to establish or reestablish the corner: FOUND "X" CHIPPED INTO WALK AS NOTED ON PG. 2 - NO REFERENCES FOUND

A description of the physical condition of the monument as found and as set or reset: MONUMENTS IN GOOD CONDITION ON RECENTLY PLACED CONCRETE.

**SURVEYOR'S STATEMENT**

This Corner Record was prepared by me or under my direction in conformance with the Land Surveyors' Act on Oct 23 1991.

Signed Ralph Scheel L.S. or R.C.E. Number L53730  

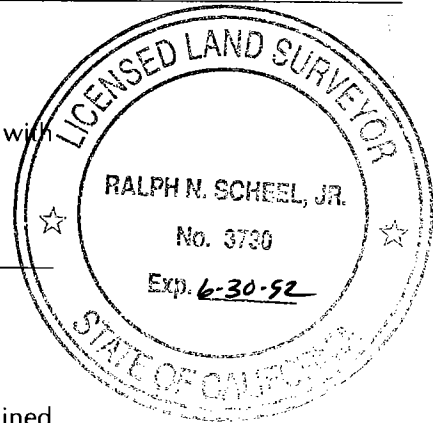


**COUNTY SURVEYOR'S STATEMENT**

This Corner Record was received December 16, 1991 and examined and filed December 23, 1991.

Signed Debra S. Dehramet Title Chief Deputy County Surveyor

County Surveyor's Comment \_\_\_\_\_

WILSON WAY

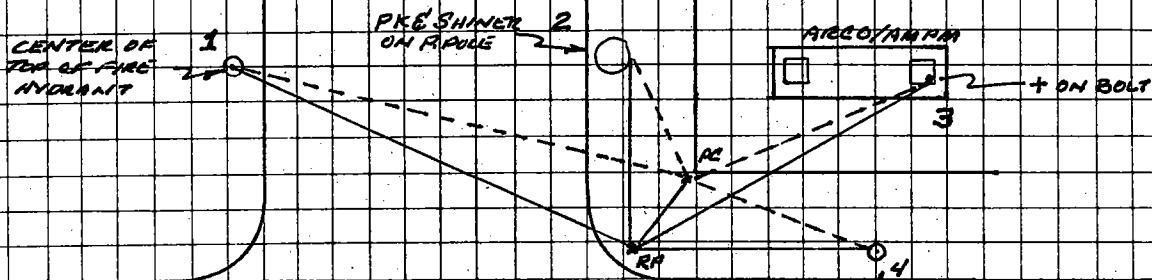

FROM REF. PT. TO

- 1 266°15'07" 30.58
- 2 351°49'31" 14.53'
- 3 38°52'01" 24.06
- 4 87°49'43" 16.94' (BASIS OF AZIMUTH)
- PIC 28°29'11" 7.53'

FROM PIC TO

- 1 261°25' — 74.84'
- 2 324°05' — 9.56'
- 3 43°35' — 16.72'
- 4 114°07' — 14.65' (BASIS OF AZIMUTH)

BRASS CAP IN WALK  
CAL. D.O.T. CM 10376

WASHINGTON ST.

