


CORNER RECORD

Document Number CR-91-014

City of STOCKTON

County of SAN JOAQUIN, California

Brief Legal Description REFERENCE TO PROPERTY CORNER AT N.E. COR. WILSON & LAFAYETTE ST.

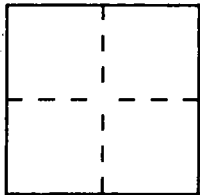

CORNER TYPE

Government Corner Control
Meander Property
Rancho Other
Date of Survey 10-23-91

**COORDINATES
(Optional)**

N. _____
E. _____
Zone _____ Datum _____
Elev. _____

Corner — Left as found Found and tagged Established Reestablished Rebuilt


Identification and type of corner found: Evidence used to identify or procedure used to establish or reestablish the corner: "+" IN GOOD CONDITION ON RECENT CONC. WALK - REFERENCE TO PROP. COR.
NO REFERENCES FOUND

A description of the physical condition of the monument as found and as set or reset: FD "+" IN
GOOD CONDITION ON RECENT CONC. WALK

SURVEYOR'S STATEMENT

This Corner Record was prepared by me or under my direction in conformance with the Land Surveyors' Act on Oct. 23 1991.

Signed Ralph Scheel Jr. L.S. or R.C.E. Number L53730
Exp 6-30-92

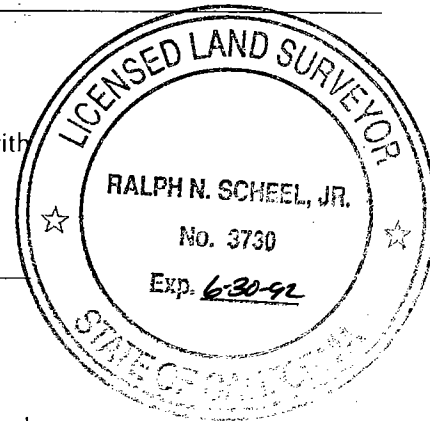

COUNTY SURVEYOR'S STATEMENT

This Corner Record was received December 16, 1991 and examined and filed December 23, 1991.

Signed Robert Debraamk Title Chief Deputy County Surveyor

County Surveyor's Comment _____

