

CORNER RECORD

Document Number CR-92-005

City of Tracy, California County of San Joaquin, California

Brief Legal Description Northwest Corner Section 29, T2S, R5E, M.D.M.



CORNER TYPE

- Government Corner
- Meander
- Rancho
- Date of Survey _____ ✓
- Control
- Property
- Other

COORDINATES (Optional)

N. _____
 E. _____
 Zone _____ Datum _____
 Elev. _____

Corner — Left as found Found and tagged Established Reestablished Rebuilt


Identification and type of corner found: Evidence used to identify or procedure used to establish or reestablish the corner:
The northwest corner of Section 29, T2S, R5E, was found as referenced on Parcel Map 79-84-MS, filed in Book 13, page 26A, San Joaquin County Records. Re-construction of the roadbed in this area will destroy this monument. The location of this monument was referenced to points outside the work area so that a new monument could be placed in the same location. See sketch on back

A description of the physical condition of the monument as found and as set or reset:
Found at this corner was a 3/4" open iron pipe approximately 0.5' below the pavement surface, with a nail in the center. Reset at this location is a 2 1/2" brass disc set in concrete in a standard monument box, marked as shown on the back of this card.

SURVEYOR'S STATEMENT

This Corner Record was prepared by me or under my direction in conformance with the Land Surveyors' Act on September 17 1992.


Signed Dennis J. Pedersen L.S. or R.C.E. Number LS 5956

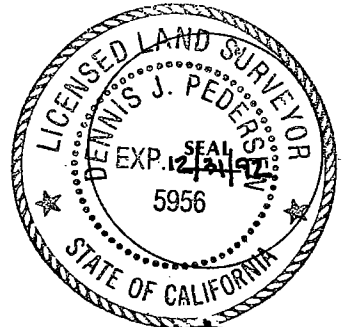

COUNTY SURVEYOR'S STATEMENT

This Corner Record was received September 23, 1992 and examined and filed September 25, 1992.

Signed Robert Dehnamak Title Chief Deputy County Surveyor

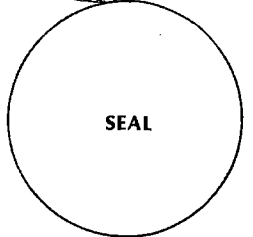

County Surveyor's Comment Reference to ties on Page 2 of 2.

