


CORNER RECORD

Document Number CR-93-002

City of MANTECA

County of SAN JOAQUIN, California

Brief Legal Description IN PORTION OF SECTION 20, T.1 S., R.7 E., M.D.B. & M.

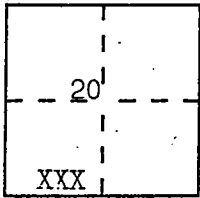

CORNER TYPE

COORDINATES (Optional)

Government Corner Control
Meander Property
Rancho Other
Date of Survey July 30, 1993

N. _____
E. _____
Zone _____ Datum _____
Elev. _____

Corner — Left as found Found and tagged Established Reestablished Rebuilt


Identification and type of corner found: Evidence used to identify or procedure used to establish or reestablish the corner: Monuments as shown on map filed in Book 32 of Surveys, Page 14, San Joaquin County Records.
(see sketch page 2 of 2)

A description of the physical condition of the monument as found and as set or reset: Set 3/4" iron pipe, 24" long, tagged L.S. 3870
(see sketch page 2 of 2)

SURVEYOR'S STATEMENT

This Corner Record was prepared by me or under my direction in conformance with the Land Surveyors' Act on DECEMBER 16, 19 93.

Signed Richard L. Fultz L.S. No. 3870 (expires 6-30-96)

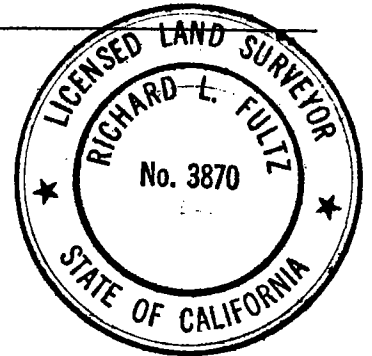

COUNTY SURVEYOR'S STATEMENT

This Corner Record was received DECEMBER 20 19 93 and examined and filed December 30, 19 93.

Signed Manuel Lopez Title Deputy Director - Public Works Dept. & Deputy County Surveyor



County Surveyor's Comment _____

