


**CORNER RECORD**

Document Number CR-95-005

City of \_\_\_\_\_ County of San Joaquin, California

Brief Legal Description N.E. Corner of N.W. 1/4 of Section 2, T4N, R6E M.D.B. & M.

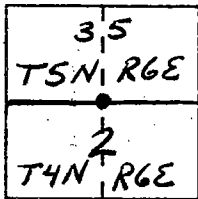

**CORNER TYPE**

Government Corner  Control   
 Meander  Property   
 Rancho  Other   
 Date of Survey 2-14-95

**COORDINATES (Optional)**

N. \_\_\_\_\_  
 E. \_\_\_\_\_  
 Zone \_\_\_\_\_ Datum \_\_\_\_\_  
 Elev. \_\_\_\_\_

Corner - Left as found  Found and tagged  Established  Reestablished  Rebuilt


Identification and type of corner found: Evidence used to identify or procedure used to establish or reestablish the corner: N.E. Corner of N.W. 1/4 of Section 2, T4N, R6E, M.D.B. & M. Fd. P.K. nail @ Surface of Lower Sacramento Road 40' E/o a California Division of Highways 6" x 6" Concrete Monument as described on P.M. 11-24

A description of the physical condition of the monument as found and as set or reset: Fd. P.K. nail with a missing head.

**SURVEYOR'S STATEMENT**

This Corner Record was prepared by me or under my direction in conformance with the Land Surveyors' Act on 2/14/1995

Signed [Signature] L.S. or R.C.E. Number 23341

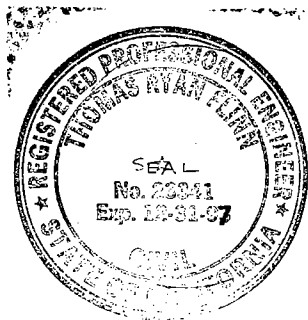

**COUNTY SURVEYOR'S STATEMENT**

This Corner Record was received March 29, 1995 and examined and filed April 19, 1995.

Signed Henry M. Hirata Title COUNTY SURVEYOR



County Surveyor's Comment \_\_\_\_\_

