


CORNER RECORD

Document Number CR-95-006

City of TRACY County of SAN JOAQUIN, California

Brief Legal Description SECTION CORNER AT NORTHEAST CORNER SECTION 29, TOWNSHIP 2 SOUTH, RANGE 5 EAST, M.D.B. & M.

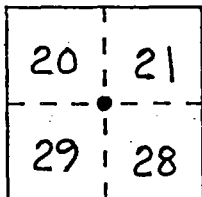

CORNER TYPE

Government Corner ☒ Control ☐
 Meander ☐ Property ☐
 Rancho ☐ Other ☐
 Date of Survey _____

COORDINATES (Optional)

N. _____
 E. _____
 Zone _____ Datum _____
 Elev. _____

Corner — Left as found ☐ Found and tagged ☐ Established ☐ Reestablished ☒ Rebuilt ☐


Identification and type of corner found: Evidence used to identify or procedure used to establish or reestablish the corner: CITY OF TRACY GPS MONUMENT NO. 18: FOUND 5/8" REBAR 0.5' DEEP IN PAVEMENT AT APPROXIMATE CENTERLINE OF ELEVENTH STREET. MONUMENT DESTROYED DURING CONSTRUCTION OF "ELEVENTH STREET IMPROVEMENTS". MONUMENT TIED OUT AS SHOWN ON DIAGRAM.

A description of the physical condition of the monument as found and as set or reset: SET 2 1/2" BRASS DISC IN 4" CAST IRON PIPE FILLED WITH CONCRETE IN MONUMENT BOX. RESET USING TIES SHOWN ON DIAGRAM. STAMPED PER DETAIL ON DIAGRAM.

SURVEYOR'S STATEMENT

This Corner Record was prepared by me or under my direction in conformance with the Land Surveyors' Act on JUNE 2, 19 94.

Signed William B. Hyzell L.S. or R.C.E. Number LS 4876

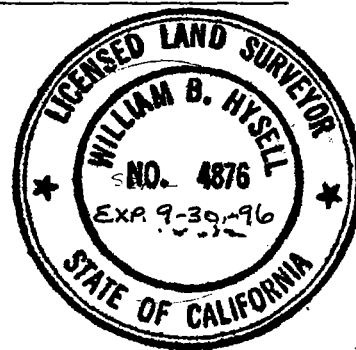

COUNTY SURVEYOR'S STATEMENT

This Corner Record was received FEBRUARY 3, 19 95 and examined and filed May 4, 19 95.

Signed Henry M. Hirata Title COUNTY SURVEYOR



County Surveyor's Comment _____

N. 1/4 COR. SEC. 29

FD RAILROAD
SPIKE
P.M. 12-79

ELEVENTH

2640.58

TRACY BOULEVARD

STREET

400'±

SEC. COR. & GFS No. 18
FD. 5/8" REBAR IN MON.
BOX, P.M. 12-79

$\angle = 265^{\circ}42'51''$

RESET. 2 1/2" BRASS
DISC IN MON. BOX

SET P.K. NAILS
IN PARKING LOT

SET 1/2"x24" I.P.
W/CONTROL PLUG



NOT TO SCALE

