


# CORNER RECORD

Document Number CR-95-007

City of TRACY County of SAN JOAQUIN, California

Brief Legal Description SECTION CORNER AT NORTHEAST CORNER SECTION 28, TOWNSHIP 2 SOUTH, RANGE 5 EAST, M.D.B.&M.

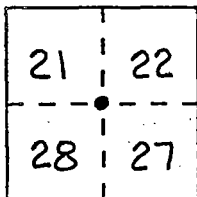

## CORNER TYPE

Government Corner ☒ Control ☐  
 Meander ☐ Property ☐  
 Rancho ☐ Other ☐  
 Date of Survey APRIL 20, 1993

## COORDINATES (Optional)

N. \_\_\_\_\_  
 E. \_\_\_\_\_  
 Zone \_\_\_\_\_ Datum \_\_\_\_\_  
 Elev. \_\_\_\_\_

Corner — Left as found ☐ Found and tagged ☐ Established ☐ Reestablished ☒ Rebuilt ☐


Identification and type of corner found: Evidence used to identify or procedure used to establish or reestablish the corner: CITY OF TRACY G.P.S. MONUMENT NO. 19: FOUND 5/8" IRON PIN IN MONUMENT WELL AT INTERSECTION OF " ELEVENTH STREET AND OLD MAC ARTHUR DRIVE. MONUMENT DESTROYED DURING CONSTRUCTION OF " ELEVENTH STREET IMPROVEMENTS". MONUMENT TIED OUT AS SHOWN ON DIAGRAM.

A description of the physical condition of the monument as found and as set or reset: SET 2-1/2" BRASS DISC IN 4" CAST IRON PIPE FILLED WITH CONCRETE IN MONUMENT BOX. RESET USING TIES SHOWN ON DIAGRAM, STAMPED PER DETAIL ON DIAGRAM.

## SURVEYOR'S STATEMENT

This Corner Record was prepared by me or under my direction in conformance with the Land Surveyors' Act on JUNE 2, 19 94.

Signed William Hyzell L.S. or R.C.E. Number LS 4876

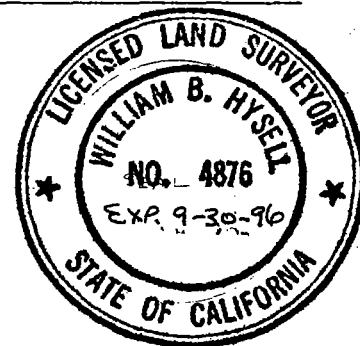

## COUNTY SURVEYOR'S STATEMENT

This Corner Record was received FEBRUARY 3, 19 95 and examined and filed May 4, 19 95.

Signed Henry M. Hirata Title COUNTY SURVEYOR



County Surveyor's Comment \_\_\_\_\_

N. 1/4 COR. SEC. 28  
FD. NAIL IN CONC. IN

MON. BOX - R.S. 30-134 ELEVENTH STREET

2642.73'

G.P.S. NO. 19  
FD. 5/8" PIN  
IN MON. BOX  
R.S. 33-25

RESET 2 1/2"  
BRASS DISC IN  
MON. BOX

$\angle = 285^{\circ}14'42''$

SET P.K. NAILS  
IN PARKING  
LOT

MAC ARTHUR DRIVE

NOT TO SCALE

