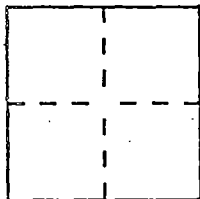


# CORNER RECORD

Document Number CR-95-010City of                      County of SAN JOAQUIN, CaliforniaBrief Legal Description 1.515 ACRE PARCEL SHOWN ON R.S. 25-116  
IN THE N.E. 1/4 OF SECTION 23, T.1S., R.7E. N.D.B.M.


## CORNER TYPE

Government Corner ☐ Control ☐  
Meander ☐ Property ☒  
Rancho ☐ Other ☐  
Date of Survey 4-24-95

## COORDINATES (Optional)

N.                       
E.                       
Zone              Datum               
Elev.             Corner — Left as found ☐ Found and tagged ☐ Established ☐ Reestablished ☒ Rebuilt ☐Identification and type of corner found: Evidence used to identify or procedure used to establish or reestablish the corner:                     see sketch on backA description of the physical condition of the monument as found and as set or reset:                     see sketch on back


## SURVEYOR'S STATEMENT

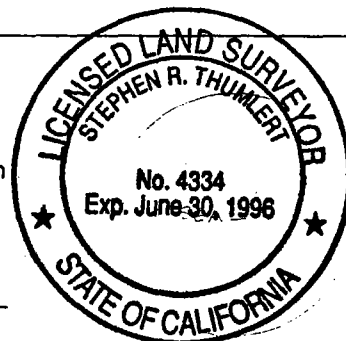This Corner Record was prepared by me or under my direction in conformance with the Land Surveyors' Act on MAY 8, 1995.Signed Stephen R. Thumbert L.S. ~~4334~~ Number L.S. 4334


## COUNTY SURVEYOR'S STATEMENT

This Corner Record was received June 21, 1995 and examined and filed June 23, 1995.Signed Henry M. Hirata Title COUNTY SURVEYORCounty Surveyor's Comment

NOT TO SCALE

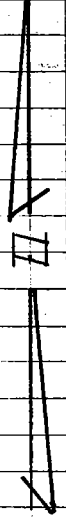

SEARCHED FOUND NOTHING  
SET 3/4" Rebar 30" Long  
WITH CAP STAMPED "L.9.4334"

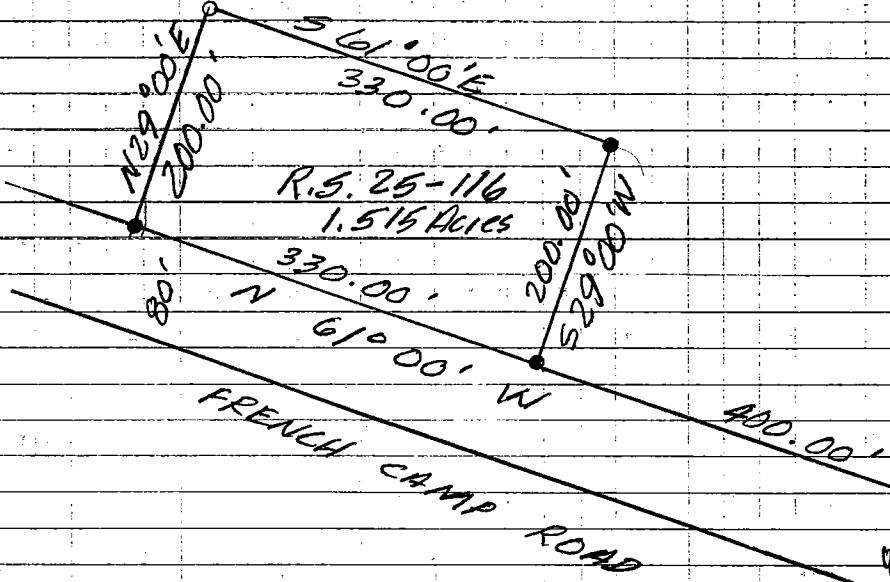

• denotes Found 1" dia.  
Iron pipe per R.S. 25-116,  
NO TAG.