


CORNER RECORD

Document Number CR-95-011

City of _____ County of SAN JOAQUIN, California

Brief Legal Description SOUTHEASTERLY CORNER OF PARCEL 2 AS SHOWN ON MAP FILED IN BK. 13 OF SURVEYS, PG. 229, SAN JOAQUIN COUNTY RECORDS. IN PORTION OF NORTHWEST QUARTER OF SECTION 28, T.1 S., R.7 E., M.D.B.& M.

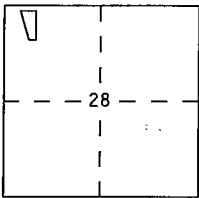

CORNER TYPE

COORDINATES (Optional)

Government Corner Control N. _____
 Meander Property E. _____
 Rancho Other Zone _____ Datum _____
 Date of Survey APRIL 19, 1995 Elev. _____

Corner — Left as found Found and tagged Established Reestablished Rebuilt

Identification and type of corner found: Evidence used to identify or procedure used to establish or reestablish the corner: SEE SKETCH PAGE 2.

- DENOTES FOUND 6" X 6" CONCRETE MONUMENT AS SHOWN ON MAP FILED IN BK. 13 OF SURVEYS, PG. 229, S.J.C.R.
- DENOTES FOUND 3/4" IRON PIN TAGGED R.C.E. 14269 AS SHOWN ON MAP FILED IN BK. 13 OF SURVEYS, PG. 229, S.J.C.R.

A description of the physical condition of the monument as found and as set or reset: ○ DENOTES SET 3/4" IRON PIPE, 24" LONG, WITH PLASTIC PLUG, STAMPED L.S. 6406

SURVEYOR'S STATEMENT

This Corner Record was prepared by me or under my direction in conformance with the Land Surveyors' Act on JUNE 3, 19 95.

Signed [Signature] L.S. or R.C.E. Number 6406



COUNTY SURVEYOR'S STATEMENT



This Corner Record was received AUGUST 1, 19 95 and examined and filed August 3, 19 95.

Signed Henry M. Hirata Title COUNTY SURVEYOR



County Surveyor's Comment _____

LATHROP ROAD

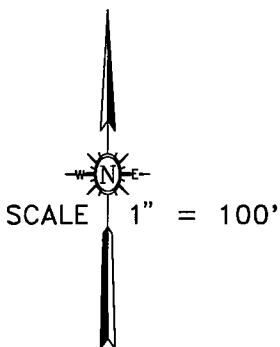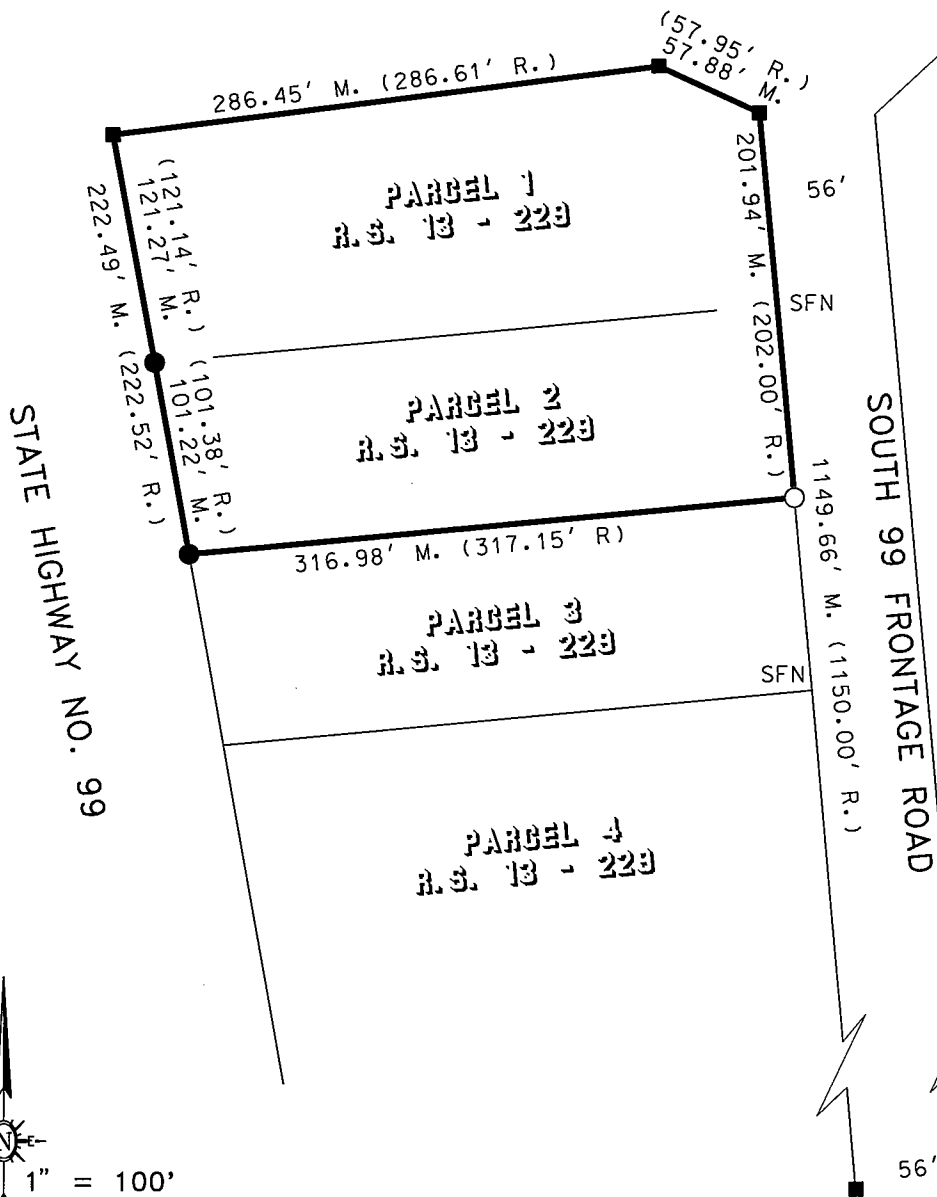

- DENOTES FOUND 6" X 6" CONCRETE MONUMENT AS SHOWN ON MAP FILED IN BK. 13 OF SURVEYS, PG. 229, S.J.C.R.
- DENOTES FOUND 3/4" IRON PIN TAGGED R.C.E. 14269 AS SHOWN ON MAP FILED IN BK. 13 OF SURVEYS, PG. 229, S.J.C.R.
- DENOTES SET 3/4" IRON PIPE, 24" LONG, WITH PLASTIC PLUG, STAMPED L.S. 6406
- M. DENOTES MEASURED DISTANCE
- (R.) DENOTES RECORD DATA AS SHOWN ON MAP FILED IN BK. 13 OF SURVEYS, PG. 229, S.J.C.R.
- SFN DENOTES SEARCHED, FOUND NOTHING
- S.J.C.R. DENOTES SAN JOAQUIN COUNTY RECORDS
- R.S. DENOTES RECORD OF SURVEY, BOOK AND PAGE, S.J.C.R.