
## **CORNER RECORD** Document Number CR-96-01 City of <u>Stockton</u> County of San Joaquin Brief Legal Description W 1/4 CQR. SECTION 14.T2NR6E.M.D.B. & M. CORNER TYPE COORDINATES (Optional) Government Corner X Control Meander ☐ Property ☐ □ Other Rancho Date of Survey \_\_\_\_\_10/5/93 Left as found X Corner -Established $\Box$ Reestablished Rebuilt Identification and type of corner found: Evidence used to identify or procedure used to establish or reestablish the corner: 3/4 INCH IRON PIN MARKING W 1/4 COR. SEC. 14 T2N R6E. PER RECORD OF SURVEY BOOK 28, PAGE 119, AND CITY OF STOCKTON SURVEY MONUMENT "2N-4". FOUND BOLT AND WASHER AT APPROXIMATE CENTERLINES OF HAMMER LANE AND WEST LANE. A description of the physical condition of the monument as found and as set or reset: 3/4 INCH IRON PIN AND BOLT AND WASHER SET IN PAVEMENT. CONTROL MONUMENT IS BRASS DISK STAMPED "CITY OF STOCKTON SURVEY MONUMENT 2N-4 R.C.E. 8189" SET IN CONCRETE IN MONUMENT WELL. SET CHISELED CROWS FEET IN CONCRETE SIDEWALK AT N.E. AND S.W. CORNERS SURVEYOR'S STATEMENT This Corner Record was prepared by me or under my direction in conformance with the Land Surveyor Act on NOVEMBER 6 ,19 95 . EXP 6-30-96 L.S. <del>or R.C.E</del>. Number <u>L6670</u> No. L6670 COUNTY SURVEYOR'S STATEMENT This Corner Record was received <u>February</u> 6, 1996 and examined and filed <u>FEBRUARY</u> 12, 1996. Signed <u>Henry M. Wirota</u> Title <u>County Surveyor</u> County Surveyor's Comment \_\_\_\_\_\_

(D.D. SHEET ZB)

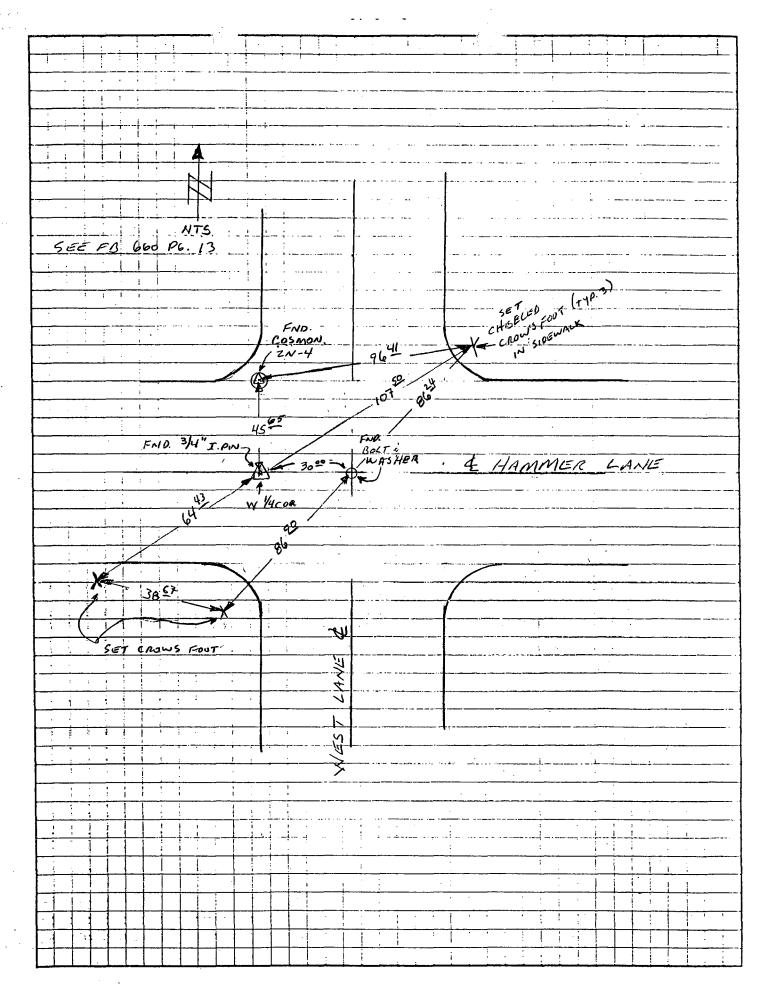

