


CORNER RECORD

City of Stockton

Document Number CR-96-02
County of San Joaquin, California

Brief Legal Description NW 1/4 SECTION 14, T2N, R6E, M.D.B.M.

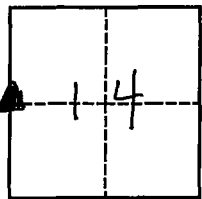

CORNER TYPE

Government Corner ☒ Control ☐
Meander ☐ Property ☐
Rancho ☐ Other ☒
Date of Survey 10/20/95

COORDINATES (Optional)

N. _____
E. _____
Zone _____ Datum _____
Elev. _____

Corner - Left as found ☐ Found and tagged ☐ Established ☐ Reestablished ☒ Rebuilt ☐

Identification and type of corner found: Evidence used to identify or procedure used to establish or reestablish the corner : FOUND CITY OF STOCKTON SURVEY MONUMENT "2N-4" AND REFERENCE CHISELED CROWS FEET. FND BENT IRON PIN MARKING W 1/4 CORNER SET IN MONUMENT WELL. REESTABLISHED W 1/4 CORNER USING "2N-4" AND REFERENCE CROWS FEET. BOLT AND WASHER AT APPROXIMATE CENTERLINE OF HAMMER AND WEST LANE REESTABLISHED USING THE SAME REFERENCES.

A description of the physical condition of the monument as found and as set or reset: 3/4 INCH IRON PIN BENT, STRAIGHTENED AND RESET IN MONUMENT WELL. CITY OF STOCKTON SURVEY MONUMENT IS BRASS DISK STAMPED "CITY OF STOCKTON SURVEY MONUMENT 2N-4 R.C.E. 8189" IN CONCRETE IN MONUMENT WELL. CHISELED CROWS FEET IN CONCRETE SIDEWALK AT THE N.E. AND S.W. CORNERS. SET 1/2 INCH REBAR WITH PLASTIC CAP MARKED "CITY OF STOCKTON" IN MONUMENT WELL AT APPROXIMATE CENTERLINE OF HAMMER AND WEST LANES.

SURVEYOR'S STATEMENT

This Corner Record was prepared by me or under my direction in conformance with the Land Surveyors' Act on NOVEMBER 6, 1995.


Signed R. E. Chesner L.S. or R.C.E. Number L6670



COUNTY SURVEYOR'S STATEMENT


This Corner Record was received February 6, 1996 and examined and filed FEBRUARY 12, 1996.

Signed Henry M. Hirata Title COUNTY SURVEYOR

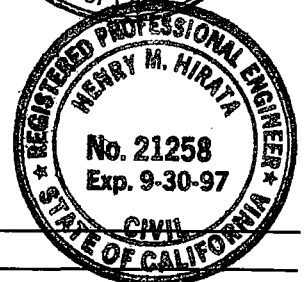

County Surveyor's Comment _____

(DD SHEET 28)

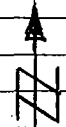

N.T.S.

SEE FB 660 PG. 13

