

# CORNER RECORD

Document Number


CR-96-06

City of RIPON

County of SAN JOAQUIN

, California

Brief Legal Description WEST 1/4 CORNER OF SECTION 19., T.2 S., R.8 E., M.D.B.& M.

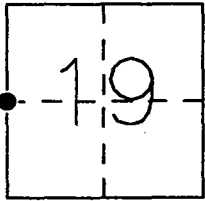

### CORNER TYPE

Government Corner  Control   
 Meander  Property   
 Rancho  Other   
 Date of Survey 10-04-95

### COORDINATES

(Optional)

N. \_\_\_\_\_  
 E. \_\_\_\_\_  
 Zone \_\_\_\_\_ Datum \_\_\_\_\_  
 Elev. \_\_\_\_\_

Corner - Left as found  Found and tagged  Established  Reestablished  Rebuilt


Identification and type of corner found: Evidence used to identify or procedure used to establish or reestablish the corner: SAN JOAQUIN COUNTY BOLT AND WASHER IN MONUMENT WELL DESTROYED DURING CONSTRUCTION OF JACK TONE ROAD IMPROVEMENTS. FOUND WITNESS CORNERS AS SHOWN ON CORNER RECORD CR-96-05.

A description of the physical condition of the monument as shown and as set or reset: SET 3/4" X 30" IRON PIPE WITH PLASTIC PLUG STAMPED LS 4876 IN MONUMENT WELL USING TIES SHOWN ON CORNER RECORD CR-96-05.

### SURVEYOR'S STATEMENT

THIS CORNER RECORD WAS PREPARED BY ME OR UNDER MY DIRECTION IN CONFORMANCE WITH THE LAND SURVEYORS' ACT ON 11/17 1995.

SIGNED William Hysell L.S. NUMBER 4876

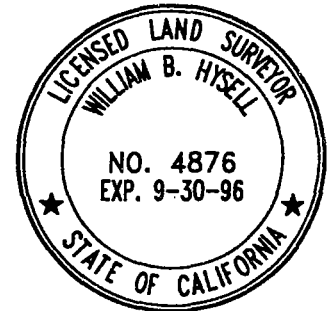

### COUNTY SURVEYOR'S STATEMENT

THIS CORNER RECORD WAS RECEIVED MARCH 22, 1996 AND EXAMINED AND FILED APRIL 9, 1996.

SIGNED Henry M. Hirata TITLE COUNTY SURVEYOR



COUNTY SURVEYOR'S COMMENT \_\_\_\_\_



NOT TO SCALE

ROAD

W 1/4 CORNER  
SEC. 19 T.2S.,R.8E.  
SET 3/4 X 30" I.P.  
IN MON WELL

FOUND  
"X" ON TOP  
OF CURB

FOUND 1/2" IRON PIPE  
WITH CONTROL PLUG

FOUND "X" ON TOP  
OF F.H.

LEGEND:  
(A) PARCEL MAP BK. 14, PG. 17  
S.J.C.R.

I.P. DENOTES IRON PIPE

JACK TONE

2645.38' (M) 2645.57' (A)

SECTION LINE

SEC. 24  
T.2S., R.7E.  
M.D.B.&M.

SEC.19, T.2S.,R.8E.,  
M.D.B.&M.

WEST MAIN STREET

SEC. 25

SEC. 30  
SEC.COR.  
FD. BRASS DISC  
IN MON. WELL (A)