

CORNER RECORD


DOCUMENT NUMBER CR-96-09

CITY OF RIPON

COUNTY OF SAN JOAQUIN,

CALIFORNIA

BRIEF LEGAL DESCRIPTION: THE WEST QUARTER CORNER OF SECTION 6, T.2 S., R.7 E., M.D.B. & M.

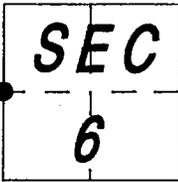

CORNER TYPE

GOV'T CORNER  CONTROL   
MEANDER  PROPERTY   
RANCHO  OTHER   
DATE OF SURVEY: JANUARY 4, 1996

COORDINATES (OPTIONAL)

N. \_\_\_\_\_  
E. \_\_\_\_\_  
ZONE \_\_\_\_\_ DATUM \_\_\_\_\_  
ELEVATION \_\_\_\_\_

CORNER - LEFT AS FOUND  FOUND AND TAGGED  ESTABLISHED  REESTABLISHED  REBUILT

IDENTIFICATION AND TYPE OF CORNER FOUND: EVIDENCE USED TO IDENTIFY OR PROCEDURE USED TO ESTABLISH OR REESTABLISH CORNER:

*5/8" IRON ROD, TAGGED L.S. 2239, AS SHOWN ON MAP OF ROBERTS ESTATES, FILED IN BOOK 32 OF MAPS AND PLATS, PAGE 49, SAN JOAQUIN COUNTY RECORDS, DESTROYED DURING INSTALLATION OF SANITARY SEWER LINE. RESET FROM FIELD TIES. SEE SKETCH SHEET 2 FOR MONUMENT TIES. (CR-96-08)*

A DESCRIPTION OF THE PHYSICAL CONDITION OF THE MONUMENT AS FOUND AND AS SET OR RESET:

*SET 3/4" IRON PIPE, TAGGED L.S.3870, IN MONUMENT WELL.*

SURVEYOR'S STATEMENT

THIS CORNER RECORD WAS PREPARED BY ME OR UNDER MY DIRECTION IN CONFORMANCE WITH THE LAND SURVEYORS' ACT ON FEBRUARY 21, 19 96.

SIGNED Richard L. Fultz L.S. NUMBER 3870  
*RICHARD L. FULTZ* (EXPIRES 6-30-96)



COUNTY SURVEYOR'S STATEMENT

THIS CORNER RECORD WAS RECEIVED APRIL 3, 19 96 AND EXAMINED AND FILED APRIL 15, 19 96.


SIGNED Henry M. Hirata TITLE COUNTY SURVEYOR



COUNTY SURVEYOR'S COMMENTS

CORNER RECORD

**THE WEST QUARTER CORNER  
OF SECTION 6,  
T.2 S., R.7 E.**

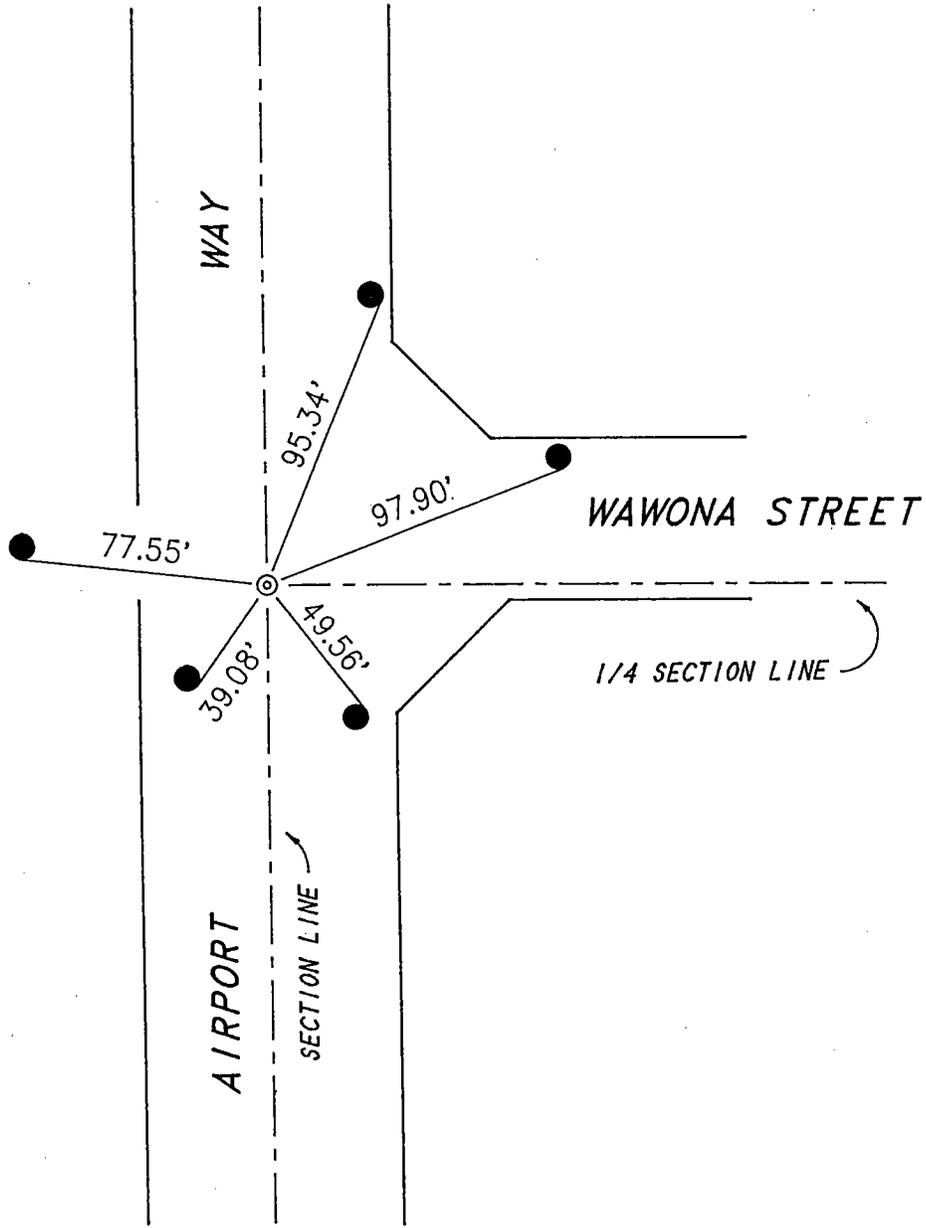

- ⊙ DENOTES SET 3/4" IRON PIPE, TAGGED L.S. 3870 IN MONUMENT WELL.
- JOINT POWER AND TELEPHONE POLE, NAIL AND SHINER IN POLE FOR MONUMENT TIE.

9318QCR2.GCD