


CORNER RECORD

Document Number CR-97-08

City of RIPON County of SAN JOAQUIN, California

Brief Legal Description A portion of lot 15 of the map of Hughes Tract filed Dec. 1910
in Book of Maps and Plats, volume 5, page 14 San Joaquin Co. records, lying in
Section 30, T.2S. R. 8, E. M.D.B. & M.

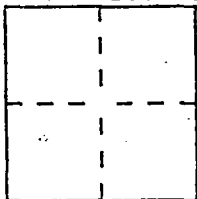

CORNER TYPE

Government Corner ☐ Control ☐
 Meander ☐ Property ☒
 Rancho ☐ Other ☐
 Date of Survey Aug. 15, 1996

COORDINATES (Optional)

N. _____
 E. _____
 Zone _____ Datum _____
 Elev. _____

Corner — Left as found ☐ Found and tagged ☐ Established ☐ Reestablished ☒ Rebuilt ☐


Identification and type of corner found: Evidence used to identify or procedure used to establish or reestablish the corner: SEE PAGE TWO

A description of the physical condition of the monument as found and as set or reset: SEE PAGE TWO

SURVEYOR'S STATEMENT

This Corner Record was prepared by me or under my direction in conformance with the Land Surveyors' Act on Aug 15, 1996.


Signed [Signature] L.S. or R.C.E. Number 28191

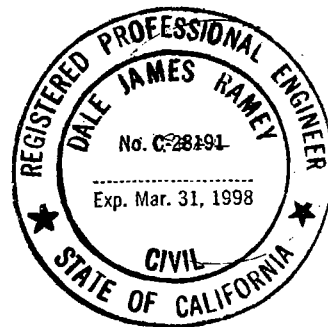


COUNTY SURVEYOR'S STATEMENT

This Corner Record was received April 10, 1997 and examined and filed APRIL 21, 1997.

Signed Henry M. Hirata Title COUNTY SURVEYOR

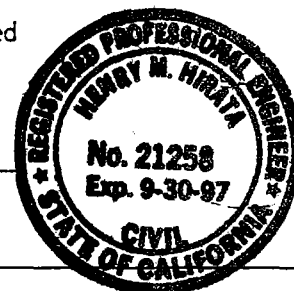

County Surveyor's Comment _____

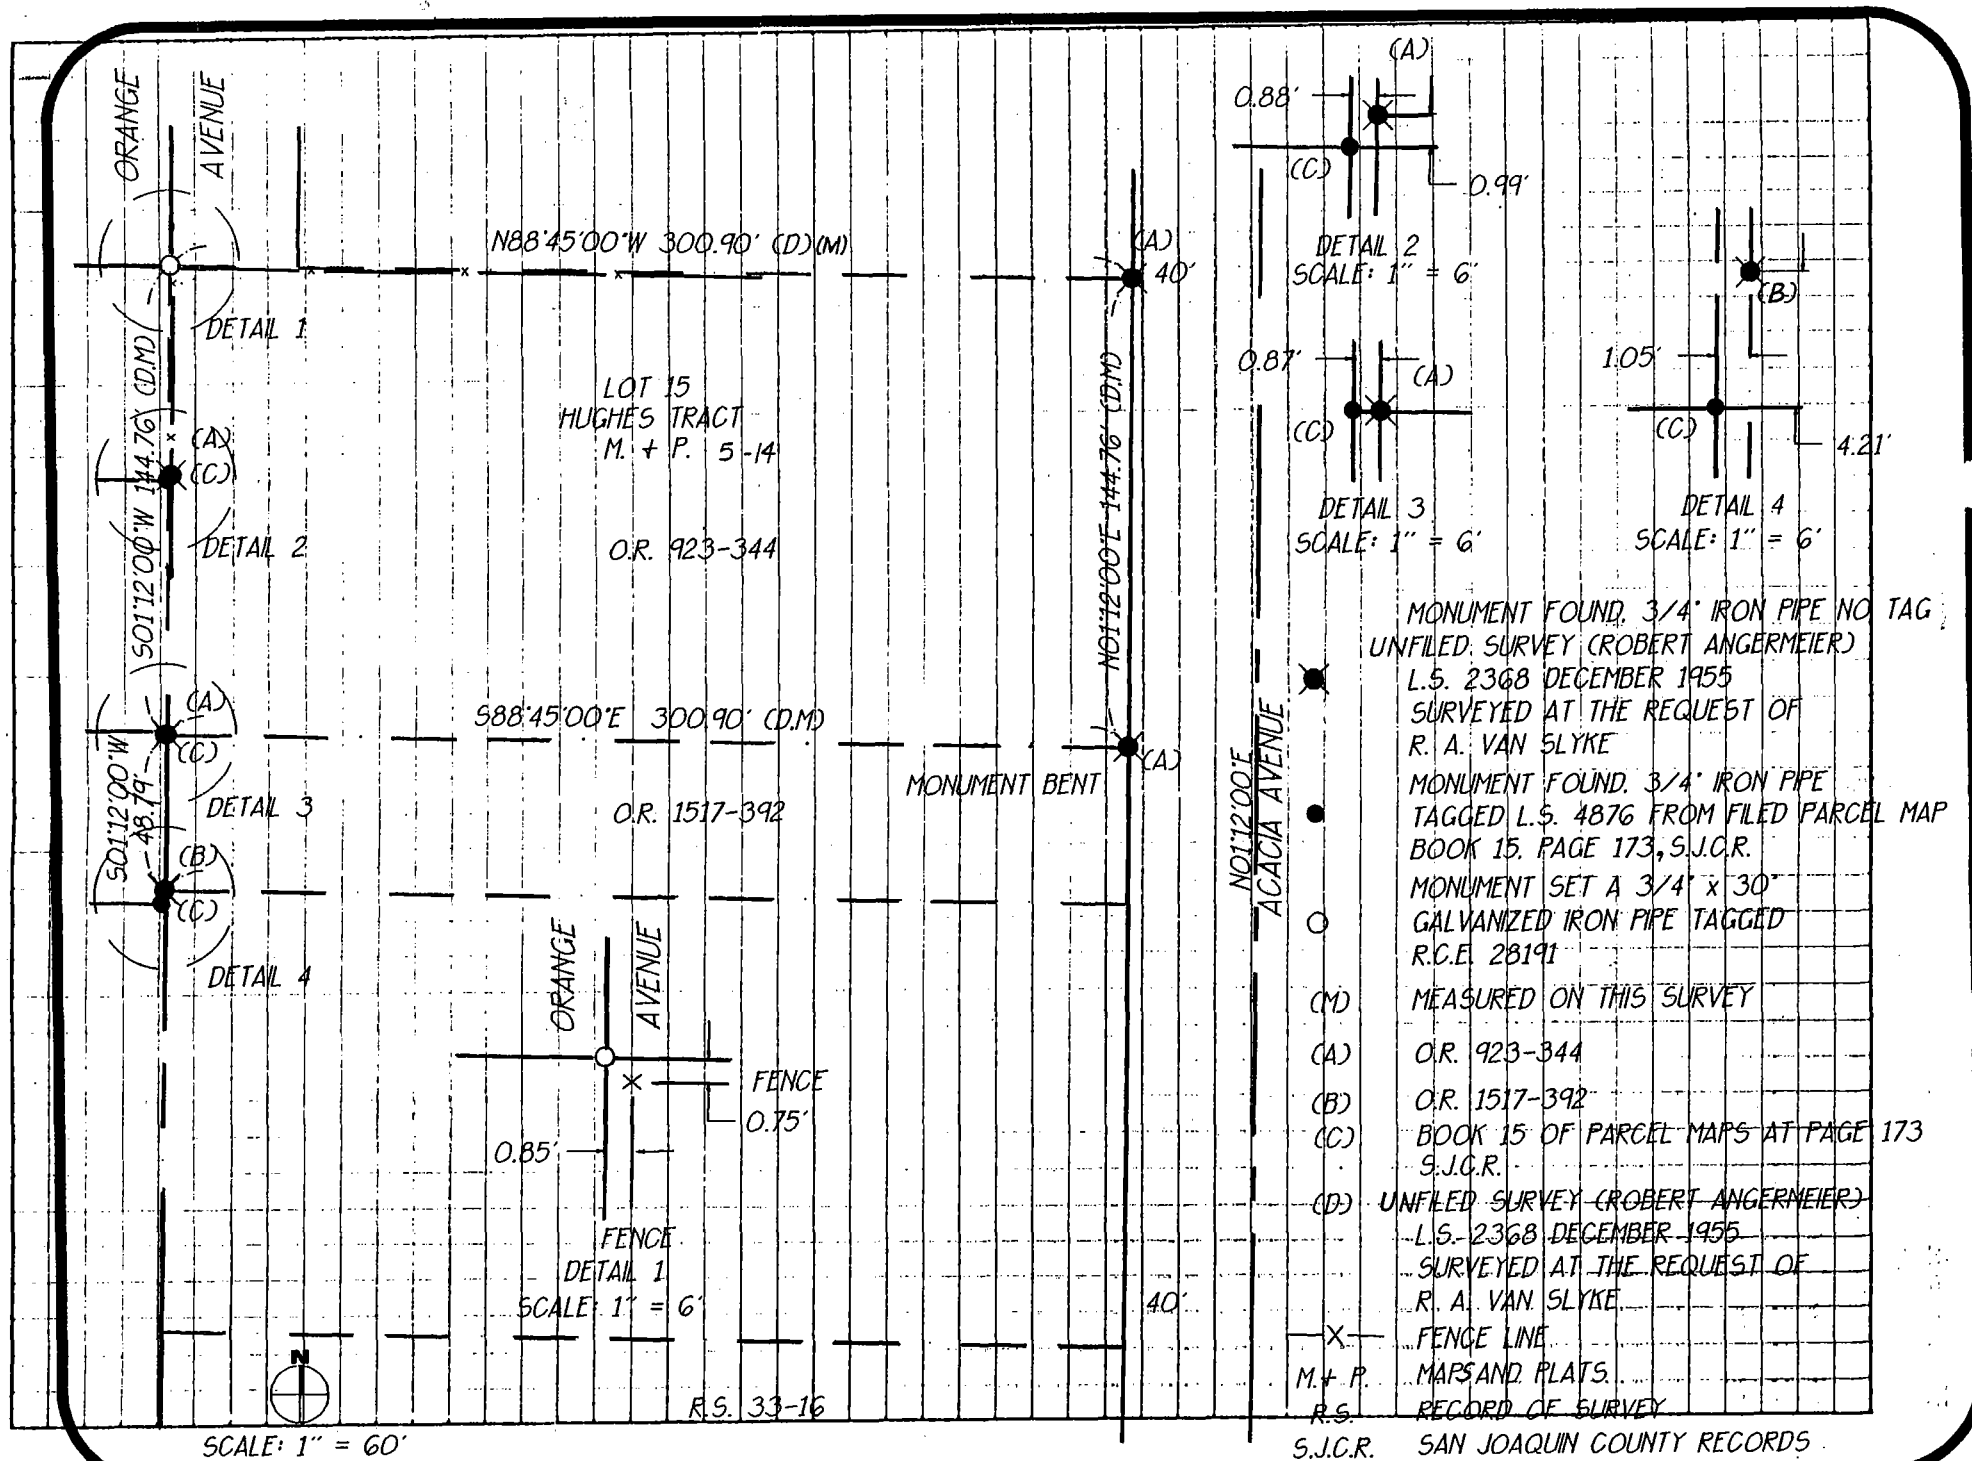

SCALE: 1" = 60'