


CORNER RECORD

Document Number CR-97-09

City of _____

County of SAN JOAQUIN, California

Brief Legal Description PARCEL SHOWN ON R.S. 11-75, portion of Lots 9 & 10 G.W. ASHLEY TRACT. POB SEC'S. 5 & 8, T.2N., R.7E., MDB.4A

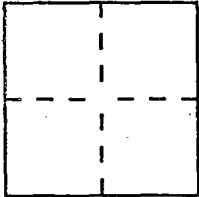

CORNER TYPE

COORDINATES (Optional)

Government Corner Control
Meander Property
Rancho Other
Date of Survey 4-16-97

N. _____
E. _____
Zone _____ Datum _____
Elev. _____

Corner — Left as found Found and tagged Established Reestablished Rebuilt


Identification and type of corner found: Evidence used to identify or procedure used to establish or reestablish the corner: see sketch on back

A description of the physical condition of the monument as found and as set or reset: see sketch on back

SURVEYOR'S STATEMENT

This Corner Record was prepared by me or under my direction in conformance with the Land Surveyors' Act on June 4, 19 97.

Signed Stephen R. Thumler L.S. or R.C.E. Number 1.5. 4334

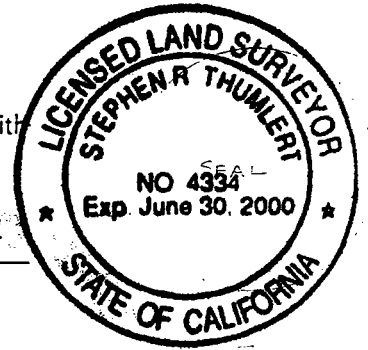

COUNTY SURVEYOR'S STATEMENT

This Corner Record was received JUNE 10, 19 97 and examined and filed JUNE 17, 19 97.

Signed Henry M. Hirata Title COUNTY SURVEYOR



County Surveyor's Comment _____

- Ed. 3/4" I. Pins per R.S. 11-75, NO TAGS
- Ed. 3/4" I. pins per P.M. 4-50, NO TAGS
- SPN SEARCHED, Found nothing

