

CORNER RECORD

Document Number


CL-91-28

City of STOCKTON

County of SAN JOAQUIN

California

Brief Legal Description SEC. 44 OF THE C.M. WEBER GRANT

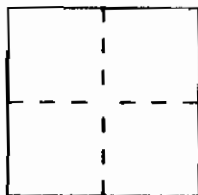

CORNER TYPE

Government Corner ☐ Control ☐
Meander ☐ Property ☐
Rancho ☐ Other ☒
Date of Survey 8-14-97

COORDINATES (Optional)

N. _____
E. _____
Zone _____ Datum _____
Elev. _____

Corner — Left as found ☒ Found and tagged ☐ Established ☐ Reestablished ☐ Rebuilt ☐


Identification and type of corner found: Evidence used to identify or procedure used to establish or reestablish the corner: FOUND AS DESCRIBED ON REVERSE OF THIS SHEET. POINT TIED OUT 8-14-97 PRIOR TO CONSTRUCTION EFFORT BY STATE OF CALIFORNIA

A description of the physical condition of the monument as found and as set or reset: THESE TIES ARE FOR THE PURPOSE OF PERPETUATING THE FOUND MONUMENT. NO CLAIM IS MADE AS TO THE RELATIONSHIP OF THE POINTS OR LINES SHOWN HEREON TO TRUE BOUNDARY LOCATIONS

SURVEYOR'S STATEMENT

This Corner Record was prepared by me or under my direction in conformance with the Land Surveyors' Act on 8-14, 1997.

Signed W J Blair L.S. or ~~R.E.~~ Number 6489
Expires 6-30-99

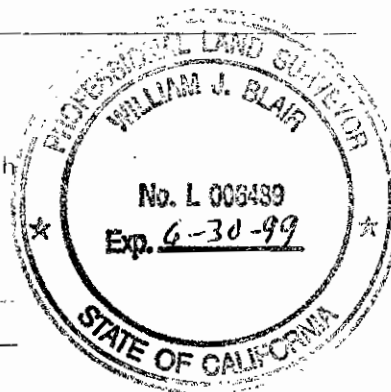


COUNTY SURVEYOR'S STATEMENT

This Corner Record was received November 14, 1997 and examined and filed DECEMBER 17, 1997.

Signed Henry M. Hirata Title County Surveyor



County Surveyor's Comment

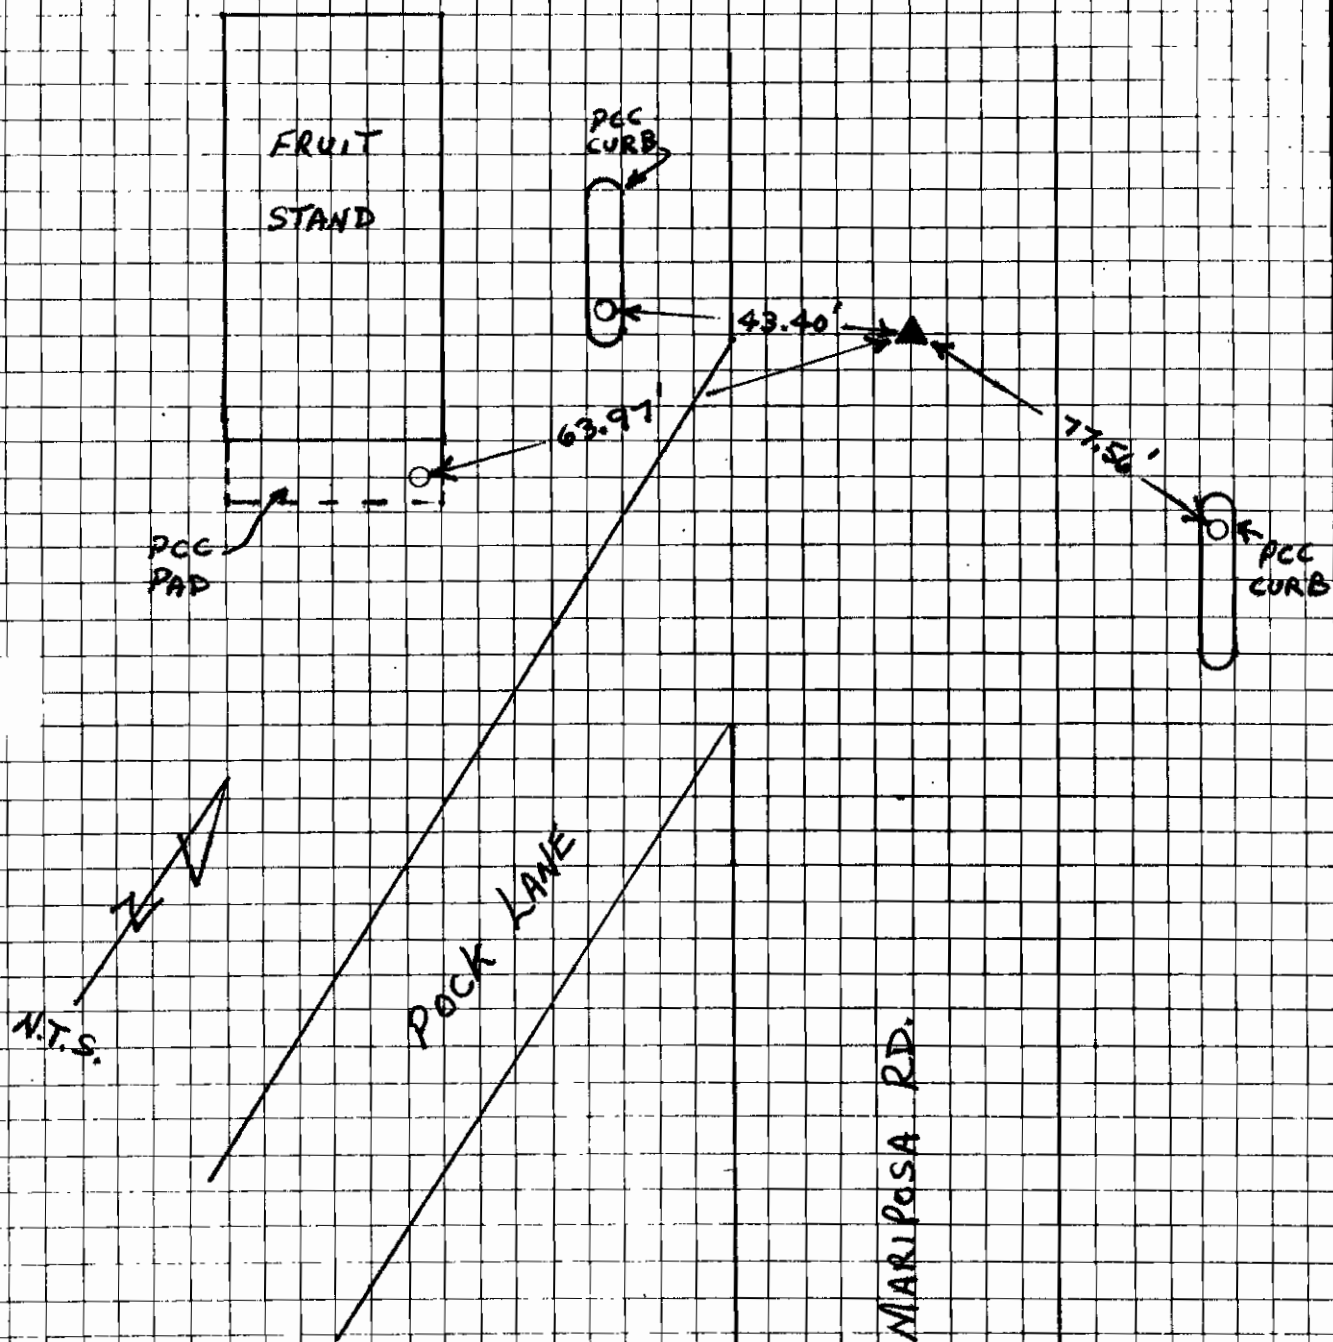

▲ = FD. STEEL PLUG IN 2 1/2" IRON PIPE
BURIED 0.7 FT. NO TAG, NO RECORD

○ = SET CHISELED "+" IN CONCRETE