

CORNER RECORD


City of STOCKTON

Document Number

CR-97-29

County of SAN JOAQUIN, California

Brief Legal Description BLOCK 123 OF "SOUTH OF NORMON CHANNEL" IN CITY OF STOCKTON ACCORDING TO THE MAP OR PLAT THEREOF

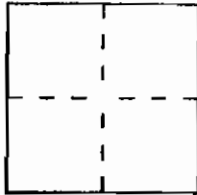

CORNER TYPE

Government Corner ☐ Control ☐
Meander ☐ Property ☐
Rancho ☐ Other ☒
Date of Survey 8-14-97

COORDINATES (Optional)

N. _____
E. _____
Zone _____ Datum _____
Elev. _____

Corner — Left as found ☒ Found and tagged ☐ Established ☐ Reestablished ☐ Rebuilt ☐

Identification and type of corner found: Evidence used to identify or procedure used to establish or reestablish the corner: FOUND AS DESCRIBED ON REVERSE SIDE OF THIS SHEET. POINTS TIED OUT 8/14/97 PRIOR TO CONSTRUCTION EFFORT BY THE STATE OF CALIFORNIA

A description of the physical condition of the monument as found and as set or reset: THESE TIES ARE FOR THE PURPOSE OF PERPETUATING THE FOUND MONUMENTATION. NO CLAIM IS MADE AS TO THE RELATIONSHIP OF THE POINTS OR LINES SHOWN HEREON TO TRUE BOUNDARY LOCATIONS.

SURVEYOR'S STATEMENT

This Corner Record was prepared by me or under my direction in conformance with

the Land Surveyors' Act on 8-14, 19 97

Signed M. J. Blane L.S. or R.L. Number 6489
Expires 6-30-99


COUNTY SURVEYOR'S STATEMENT

This Corner Record was received November 14, 19 97 and examined

and filed DECEMBER 17, 19 97

Signed Henry M. Hirata Title County Surveyor

County Surveyor's Comment _____

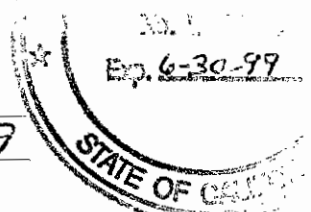

● = PD CHISELED "H" IN TOP OF CURB

○ = SET PK NAIL TAGGED WITH BRASS "CALTRANS" WASHER

