CORNER RECORD

Document Number CR-97-34

City of —

County of San Joaquin, California

Brief Legal Description Intersection of R.O.W. ℄'s of Valpico Rd. and Fairoaks Rd.

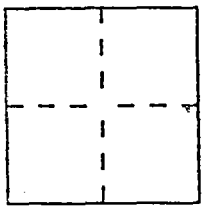

CORNER TYPE

Government Corner ☐ Control ☑
Meander ☐ Property ☐
Rancho ☐ Other ☐
Date of Survey 6-10-96

COORDINATES *(Optional)*

N.
E.
Zone Datum
Elev.

Corner — Left as found ☒ Found and tagged ☐ Established ☐ Reestablished ☐ Rebuilt ☑

Identification and type of corner found: Evidence used to identify or procedure used to establish or reestablish the corner: Intersection of R.O.W. ℄'s of Valpico Rd. and Fairoaks Rd. Fd. monument as described on P. 16 of F.B. 627 S.J.G. Surveyor's Records

A description of the physical condition of the monument as found and as set or reset: Spike and washer @ surface. Set monument box over point.

SURVEYOR'S STATEMENT

This Corner Record was prepared by me or under my direction in conformance with the Land Surveyors' Act on Dec. 18, 19 97.

Signed [illegible] ~~L.S. or~~ R.C.E. Number 23341

REGISTERED PROFESSIONAL ENGINEER THOMAS RYAN FLINN SEAL No. 23341 Exp. 12-31-97 01 CIVIL STATE OF CALIFORNIA

COUNTY SURVEYOR'S STATEMENT

This Corner Record was received December 18, 19 97 and examined and filed JANUARY 2, 19 98

Signed Henry M Hirata Title COUNTY SURVEYOR

REGISTERED PROFESSIONAL ENGINEER HENRY M. HIRATA SEAL No. 21258 Exp. 9-30-01 CIVIL STATE OF CALIFORNIA

County Surveyor's Comment

PWA-102 (8/88) (D.D. SHEET NO. 54 & 68)

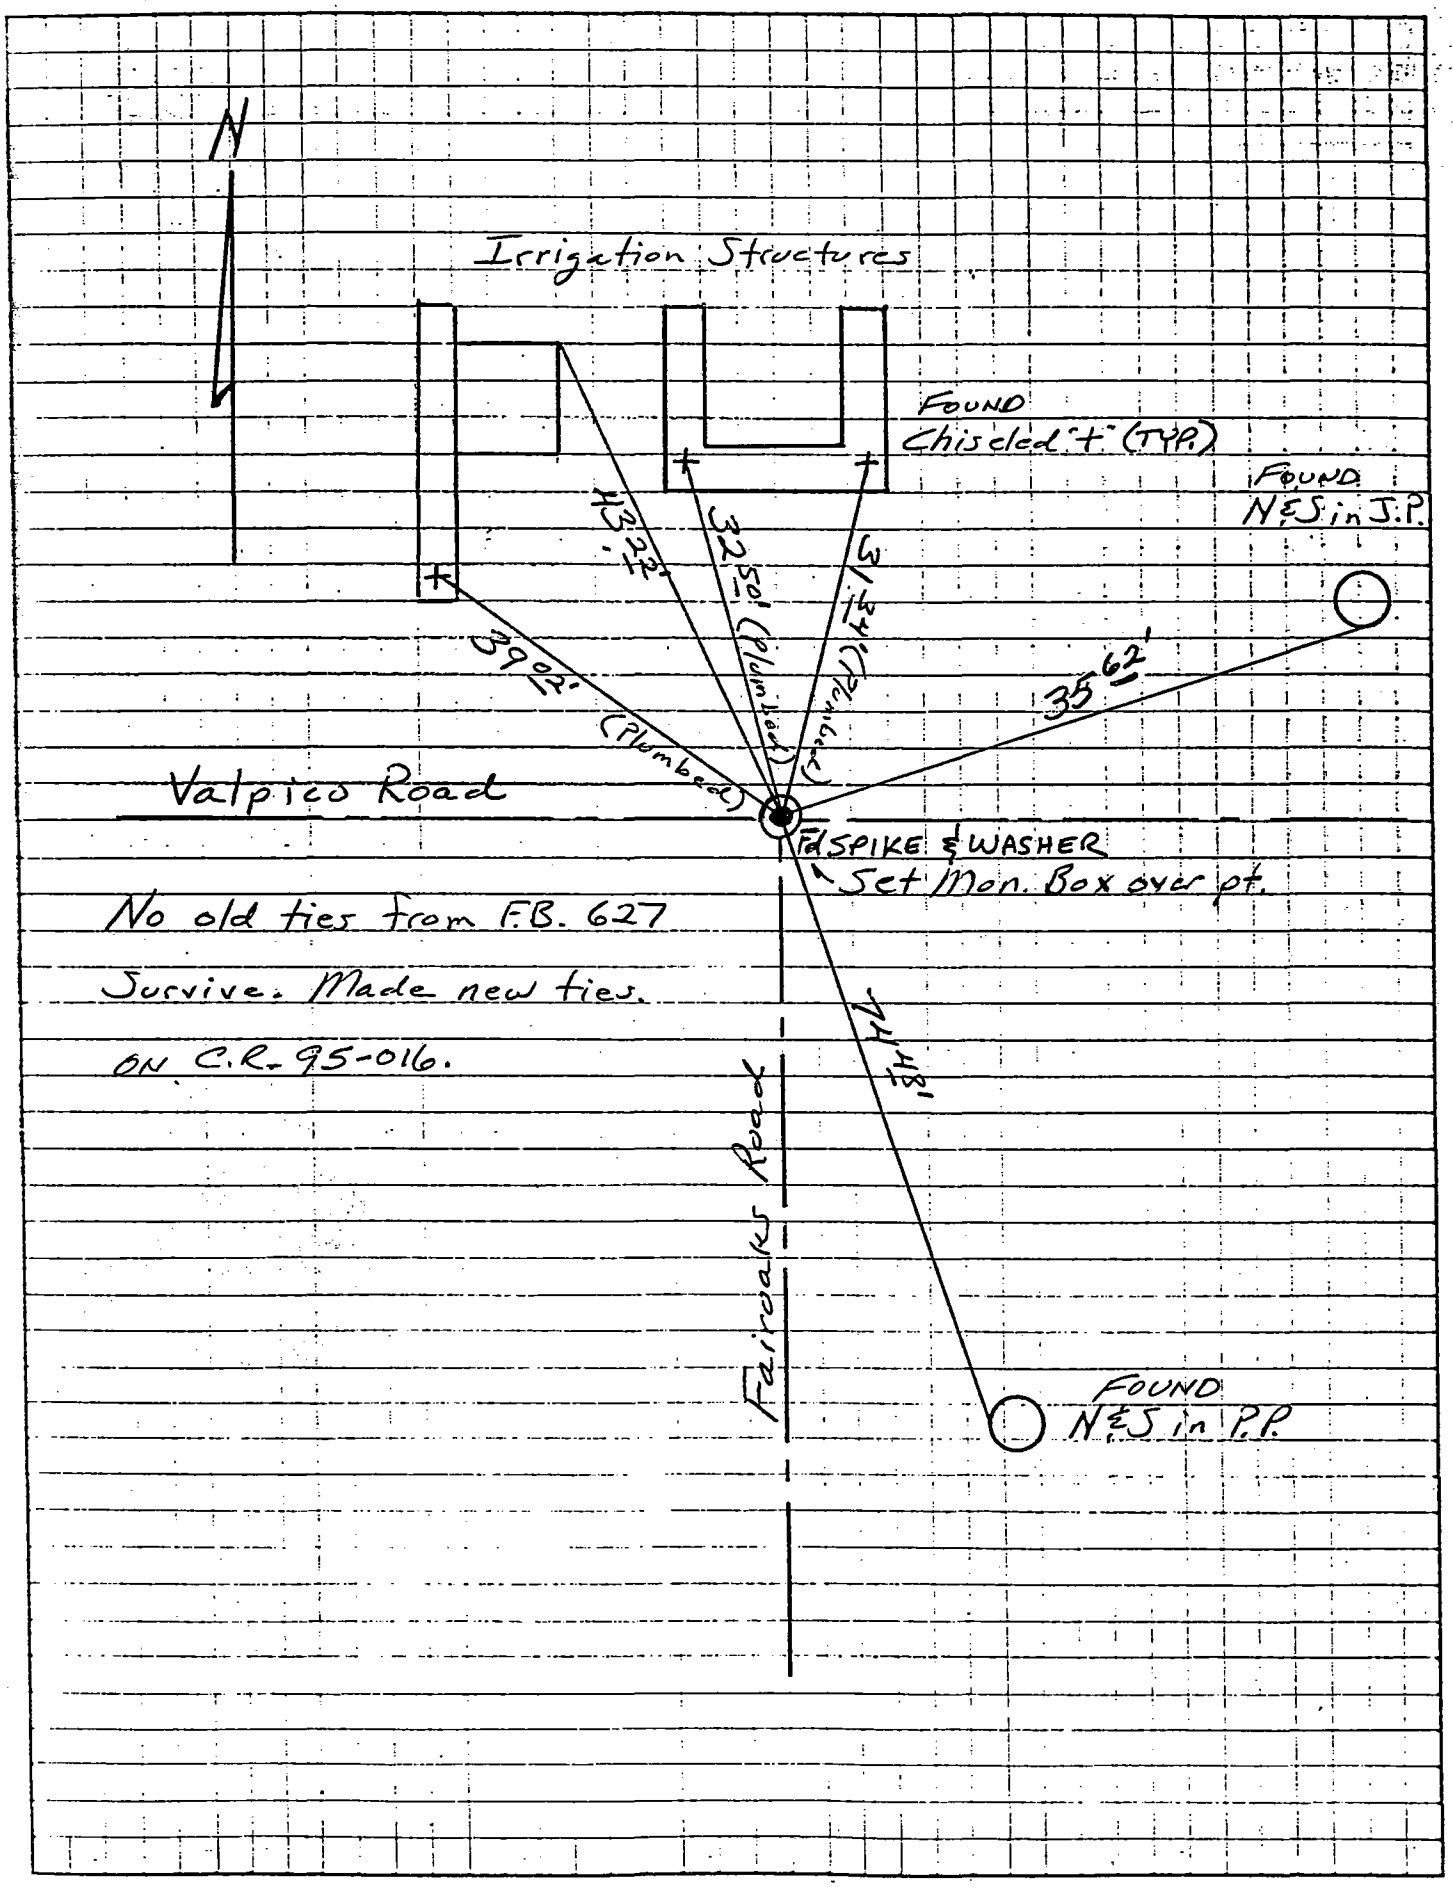
N
Irrigation Structures
FOUND
Chiseled "+" (TYP.)
FOUND
N&S in J.P.
43.22'
32.50' (Plumbed)
34.17' (Plumbed)
39.02' (Plumbed)
35.62'
Valpico Road
Fd SPIKE & WASHER
Set Mon. Box over pt.
No old ties from F.B. 627
Survive. Made new ties.
ON C.R. 95-016.
Fairoaks Road
74.48'
FOUND
N&S in P.P.