CORNER RECORD

Document Number CR-97-37

City of — County of San Joaquin, California

Brief Legal Description N/E Corner of Sec. 14, T.2S., R.8E. M.D.B. & M.

11	12
14	13

T.2.S., R.8E
M.D.B. & M.

CORNER TYPE

Government Corner ☑ Control ☐
Meander ☐ Property ☐
Rancho ☐ Other ☐
Date of Survey 11-17-95

COORDINATES *(Optional)*

N. ____
E. ____
Zone ____ Datum ____
Elev. ____

Corner — Left as found ☒ Found and tagged ☐ Established ☐ Reestablished ☐ Rebuilt ☒

Identification and type of corner found: Evidence used to identify or procedure used to establish or reestablish the corner: N/E Corner of Sec. 14, T.2S., R.8E., M.D.B. & M. Fd. monument as described on R.S. 29-165 S.J. Co. records.

A description of the physical condition of the monument as found and as set or reset: Fd. 3/4" Ø pipe w/plastic cap. Set monument box over point.

SURVEYOR'S STATEMENT

This Corner Record was prepared by me or under my direction in conformance with the Land Surveyors' Act on Dec 18, 1997.

Signed [signature] ~~L.S. or~~ R.C.E. Number 23341

REGISTERED PROFESSIONAL ENGINEER THOMAS RYAN FLINN SEAL No. 23341 Exp. 12-31-97 CIVIL STATE OF CALIFORNIA

COUNTY SURVEYOR'S STATEMENT

This Corner Record was received December 18, 1997 and examined and filed January 2, 1998.

Signed Henry M. Hirata Title COUNTY SURVEYOR

REGISTERED PROFESSIONAL ENGINEER HENRY M. HIRATA SEAL No. 21258 Exp. 9-30-01 CIVIL STATE OF CALIFORNIA

County Surveyor's Comment

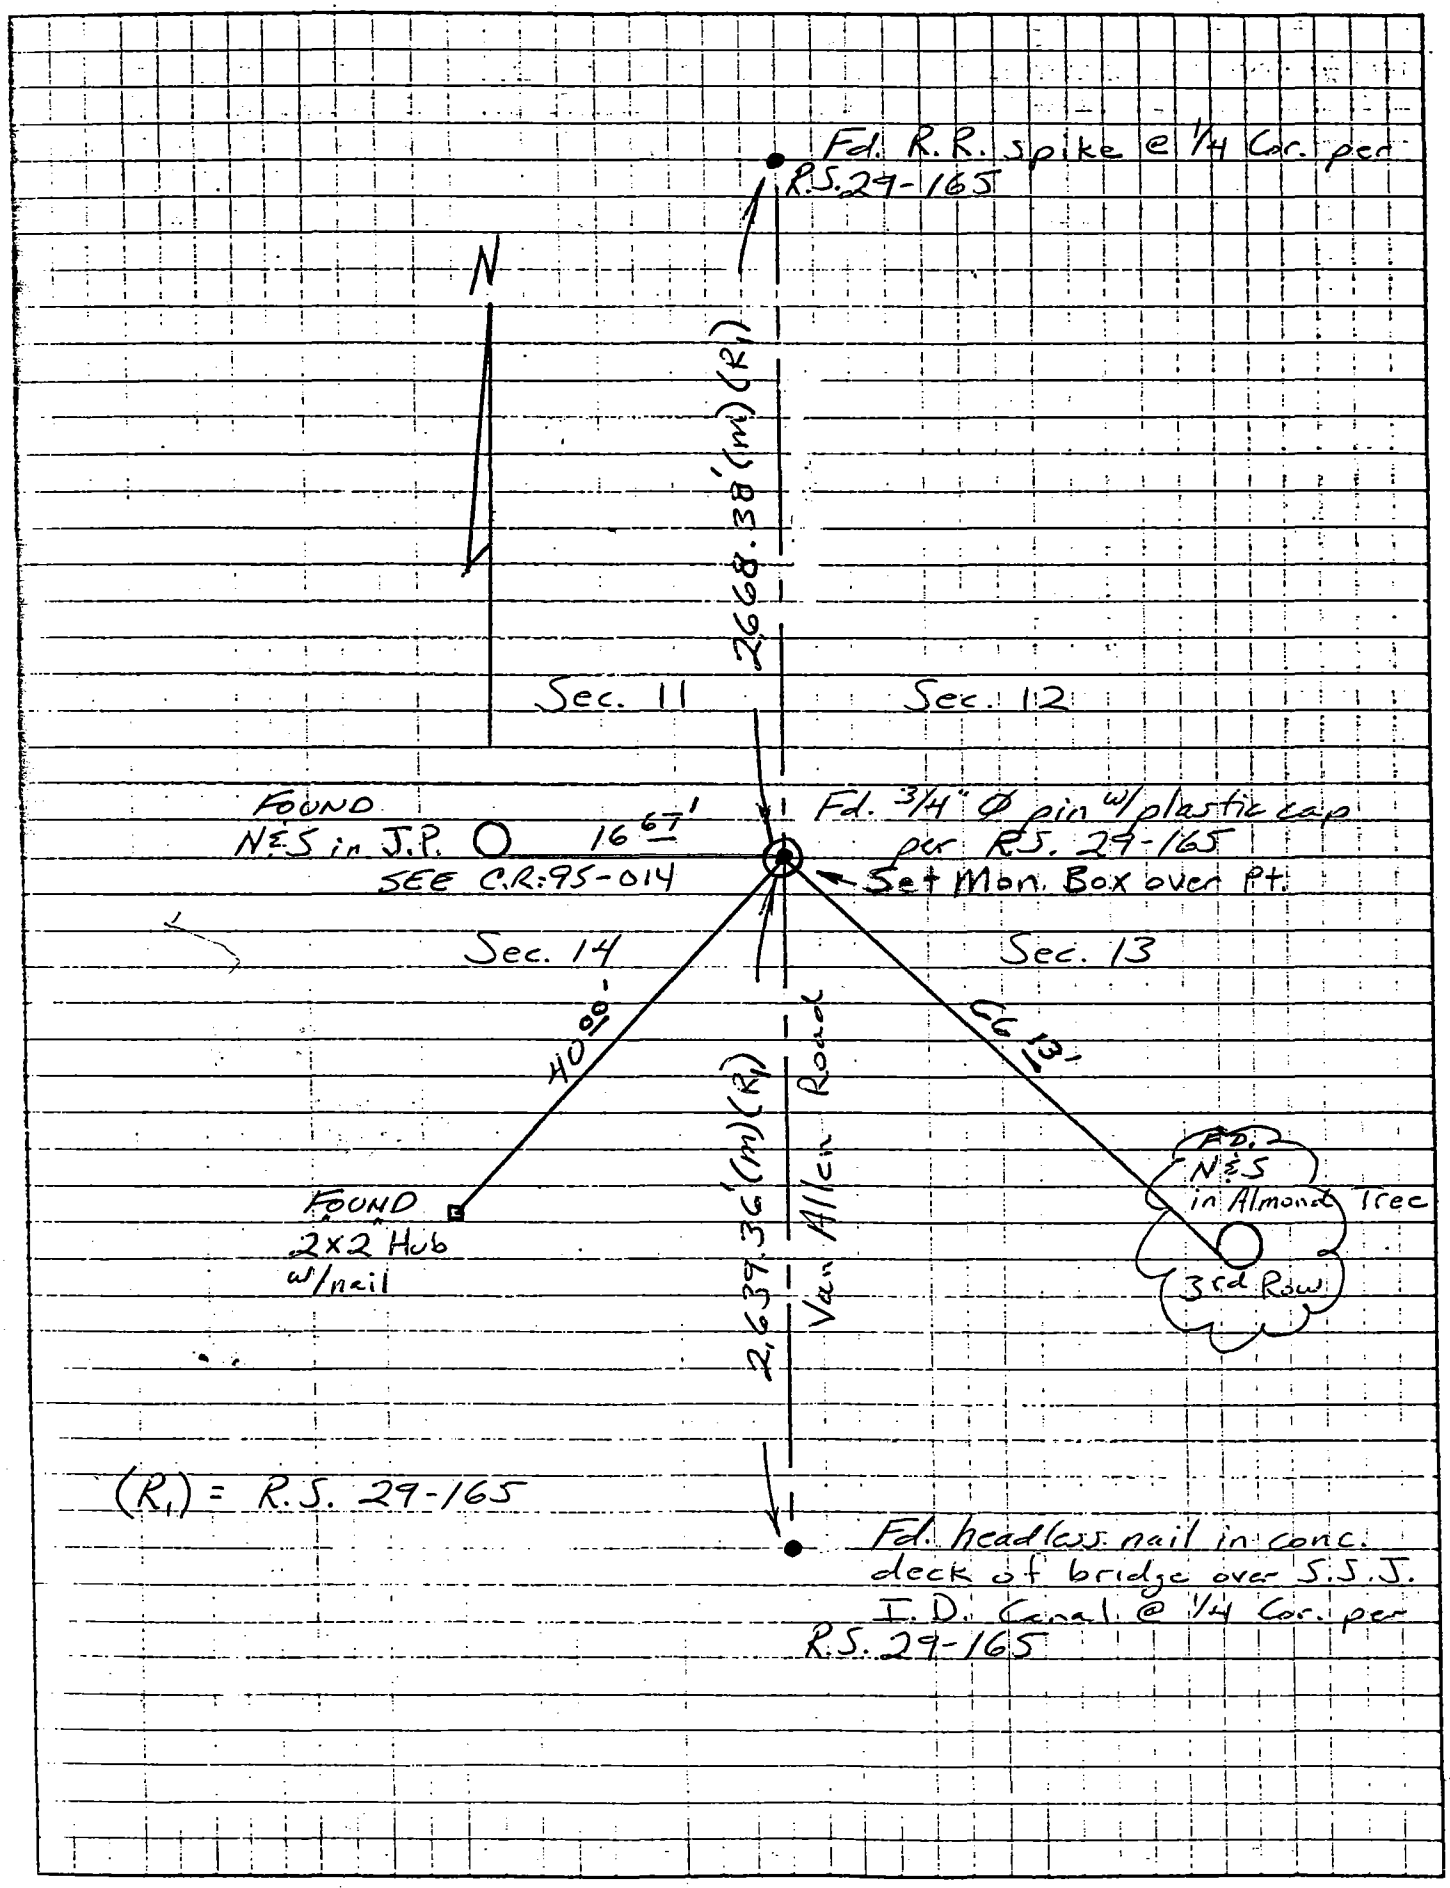
Fd. R.R. spike @ 1/4 Cor. per R.S. 29-165
N
2668.38' (m) (R1)
Sec. 11
Sec. 12
FOUND N&S in J.P.
16 6/7'
SEE C.R.95-014
Fd. 3/4" Ø pin w/plastic cap per R.S. 29-165
Set Mon. Box over Pt.
Sec. 14
Sec. 13
40.00'
26.13'
2,639.36' (m) (R1)
Van Allen Road
FOUND 2x2 Hub w/nail
Fd. N&S in Almond Tree
3rd Row
(R1) = R.S. 29-165
Fd. headless nail in conc. deck of bridge over S.J.J. I.D. Canal @ 1/4 Cor. per R.S. 29-165