


CORNER RECORD

Document Number **CR-97-38**

City of **STOCKTON**

County of **SAN JOAQUIN**, California

Brief Legal Description **SEC. 9 OF THE C.M. WEBER GRANT**

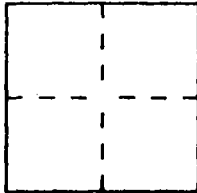

CORNER TYPE

COORDINATES (Optional)

Government Corner Control
Meander Property
Rancho Other
Date of Survey **8-14-97**

N. _____
E. _____
Zone _____ Datum _____
Elev. _____

Corner - Left as found Found and tagged Established Reestablished Rebuilt


Identification and type of corner found: Evidence used to identify or procedure used to establish or reestablish the corner: **FOUND AS PER PARCEL MAP BK. 8, PG. 49 SJCR, POINTS TIED OUT 8-14-97 PRIOR TO CONSTRUCTION BY STATE OF CALIFORNIA.**

A description of the physical condition of the monument as found and as set or reset: **THESE TIES ARE FOR THE PURPOSE OF PERPETUATION OF THE FOUND MONUMENT.**

SURVEYOR'S STATEMENT

This Corner Record was prepared by me or under my direction in conformance with the Land Surveyors' Act on **8-14**, 19**97**.

Signed **W. J. Blair** L.S. or ~~Eng.~~ Number **6489** Expires **6-30-99**

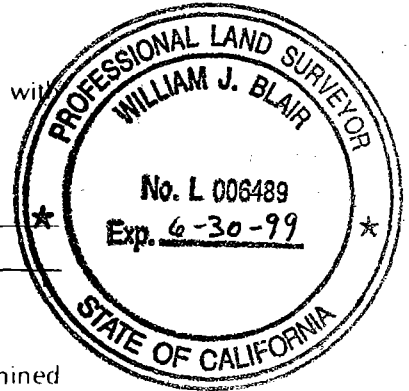

COUNTY SURVEYOR'S STATEMENT

This Corner Record was received **December 31**, 19**97** and examined and filed **January 7**, 19**98**.

Signed **Henry M. Hirata** Title **COUNTY SURVEYOR**

County Surveyor's Comment _____

