


CORNER RECORD

Document Number CL-97-40

City of ESCALON

County of SAN JOAQUIN, California

Brief Legal Description A PORTION OF THE N.E. 1/4 OF SECTION 9, T.25 R.9 E. M.D.B. 1/4 AND SHOWN ON MAP 33-08

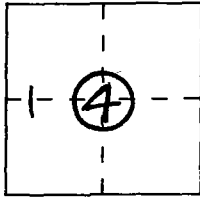

CORNER TYPE

Government Corner Control
Meander Property
Rancho Other
Date of Survey NOV. 12, 1997

COORDINATES (Optional)

N. N/A
E. _____
Zone _____ Datum _____
Elev. _____

Corner — Left as found Found and tagged Established Reestablished Rebuilt


Identification and type of corner found: Evidence used to identify or procedure used to establish or reestablish the corner:
CORNERS NOT FOUND. REESTABLISHED AS PER CONTROL ON ORCHARD PARK UNIT NO. 1, BOOK 33 OF MAPS AND PLATS, AT PAGE 08. DETAILED ON BACK HERE OF.

A description of the physical condition of the monument as found and as set or reset: CORNERS AS DESCRIBED ON REVERSE SIDE HERE OF SET IN POSITIONS SHOWN.

SURVEYOR'S STATEMENT

This Corner Record was prepared by me or under my direction in conformance with the Land Surveyors' Act of DECEMBER 1, 1997.

Signed Alan Divers L.S. or R.C.E. Number LS#6013

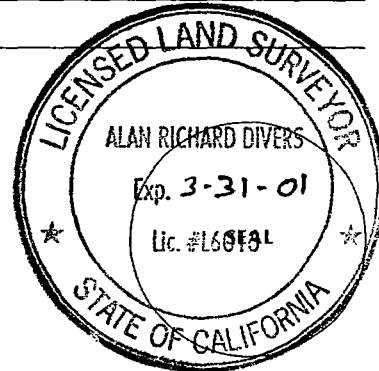

COUNTY SURVEYOR'S STATEMENT

This Corner Record was received JANUARY 5, 1998 and examined and filed JANUARY 21, 1998.

Signed Henry M. Hirata Title COUNTY SURVEYOR



County Surveyor's Comment _____

