


CORNER RECORD

DPD-3011 (NEW 11/93)

Document Number CR-97-42

City of _____ County of San Joaquin, California

Brief Legal Description W 1/4 Cor, Sec 11, T2S, R7E M.D.M. (P.M. 12-53)

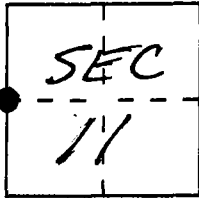

CORNER TYPE

Government Corner Control
 Meander Property
 Rancho Other
 Date of Survey 10-20-97

Coordinates (Optional)

N. 641,798.808 Meters
 E. 1940,157.785 Meters
 Zone 3 NAD: '27 '83 X
 NAD-83 Epoch 1986
 Elevation _____

Corner — Left as found Found and tagged Established Reestablished Rebuilt

Identification and type of corner found: Evidence used to identify or procedure used to establish or reestablish the corner:

Found 5/8 inch diameter iron pin down 0.1 foot below asphalt surface, at W 1/4 Cor. Sec 11, per (P.M. 12-53)

A description of the physical condition of the monument as found and as set or reset: The corner was found in good condition. Reference points were set because it will be destroyed during road construction. It will be reset after construction is complete.

SURVEYOR'S STATEMENT

This Corner Record was prepared by me or under my direction in conformance with the Land Surveyors' Act on 10-20, 1997.

Signed Patrick D. Gibbs L.S. or P.C.E. Number 5665
 For the State of California
 Department of Transportation



COUNTY SURVEYOR'S STATEMENT


This Corner Record was received 1-13, 1998 and examined and filed January 27, 1998.

Signed Henry M. Hirata Title COUNTY SURVEYOR



County Surveyor's Comment _____

Found 2" dia. Brass disk
 down 0.2 meter in Survey
 Mon. Well, Stamped:
 PE9338
 at NW Cor. Sec 11
 per (R.S. 33-154)

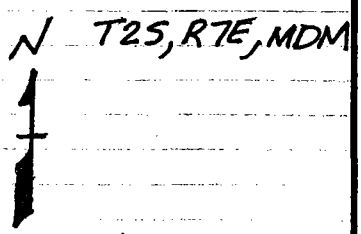

No Scale
 P. Gibbs 10-20-97

Note: All distances are
 grid meters. CF = 0.99993159
 See CALTRANS File SR 970857
 for raw measurements.

429.525 METERS

AUSTIN ROAD

GRAVES ROAD

Set PK nail
 w/ CALTRANS Washer

375.461 METERS

Found 5/8" Iron pin at
 W 1/4 Cor. Sec. 11
 per (P.M. 12-53)

180° 00' 00"

METERS
 93.512

State Route 99

Set PK nail w/ CALTRANS Washer
 in bridge deck expansion joint
 0.4 meters West of yellow stripe.