


CORNER RECORD

Document Number CR-97-43

City of _____ County of San Joaquin, California

Brief Legal Description North 1/4 Corner of Section 1, T4N, R8E
M.D.B. & M. (P.M. 11-35)

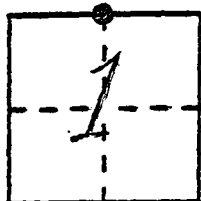

CORNER TYPE

Government Corner Control
Meander Property
Rancho Other
Date of Survey 11-4-97

COORDINATES

(Optional)
N. 692815.106 Meters
E. 1951709.179 "
Zone 3 Datum 83(92)
Elev. _____

Corner — Left as found Found and tagged Established Reestablished Rebuilt


Identification and type of corner found: Evidence used to identify or procedure used to establish or reestablish the corner:
Found 3/4" Iron pipe (No Tag), down 1.5 Ft. in S.J.Co. Mon.
Box per San Joaquin County Book 11 of Parcel Maps
at page 35.

A description of the physical condition of the monument as found and as set or reset: Found in good
condition. The monument is planned to be preserved during
road construction. The reference points were set in case
the monument is accidentally disturbed.

SURVEYOR'S STATEMENT

This Corner Record was prepared by me or under my direction in conformance with
the Land Surveyors' Act on 11-8- 1997.

Signed Patrick D. Gibbs (LS) of P.C.E. Number 5665

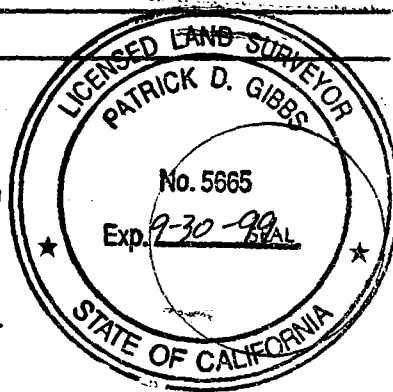

COUNTY SURVEYOR'S STATEMENT


This Corner Record was received 1-13, 1998 and examined
and filed January 27, 1998.

Signed Henry M. Hirata Title COUNTY SURVEYOR



County Surveyor's Comment _____

T4N, R8E, M.D.B & M.

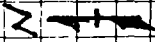

1:1000 Metric Scale (1" = 25.4 meters)


● Found 3/4" Iron pipe down 1/2 Ft. in S.J. Co. Mon. Box (P.M. 11-35)

○ Set PK nail in CALTRANS Washer

() Record Distance per P.M. 11-35 *

M = Meters

North 1/4 Cor. Section 1

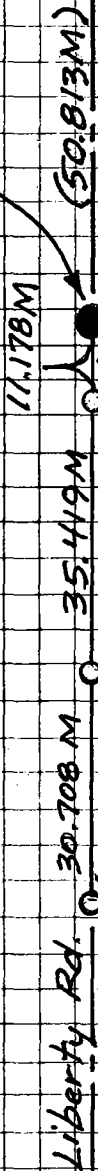

Random RP line near yellow stripe

Note: The RP distances are grid meters, Combined factor = 0.99996020 See Caltrans District 10 Survey file SR 971004 for raw measurements

* The ties shown hereon are for the purpose of perpetuating the monumentation currently existing. No attempt was made to determine the validity of the monuments or their proper location in relation to legal boundary lines in the area.