


CORNER RECORD

Document Number CR-97-46

City of TRACY

County of SAN JOAQUIN, California

Brief Legal Description SECTION CORNER COMMON TO SECTIONS 19, 20 AND RANCHO EL PESCADERO GRANT LINE, T. 2 S., R. 5 E., M.D.M.

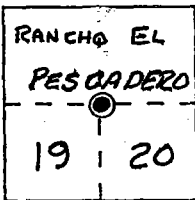

CORNER TYPE

COORDINATES (Optional)

Government Corner Control
Meander Property
Rancho Other
Date of Survey 6-30-94

N. _____
E. _____
Zone _____ Datum _____
Elev. _____

T. 2 S., R. 5 E.

Corner -- Left as found Found and tagged Established Reestablished Rebuilt


Identification and type of corner found: Evidence used to identify or procedure used to establish or reestablish the corner: AS A SUBCONTRACTOR FOR GRANITE CONSTRUCTION COMPANY, I REFERENCED OUT EXISTING MONUMENT PRIOR TO ROADWAY RECONSTRUCTION FOR THE CITY OF TRACY. (SEE PAGE 2)

A description of the physical condition of the monument as found and as set or reset: FOUND RAILROAD SPIKE ACCEPTED AS SECTION CORNER PER R.S. 10-218, R.S. 11-30, R.S. 17-93, R.S. 29-97, R.S. 30-60, P.M. 5-32, P.M. 5-79, P.M. 15-52 AND M.P. 29-9.

SURVEYOR'S STATEMENT

This Corner Record was prepared by me or under my direction in conformance with the Land Surveyors' Act on DECEMBER 30, 1997.

Signed [Signature] L.S. or P.C.E. Number 4233

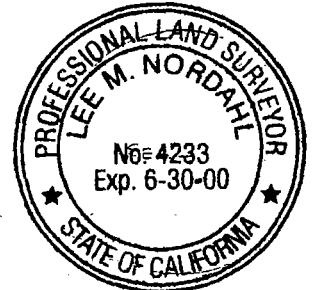

COUNTY SURVEYOR'S STATEMENT

This Corner Record was received FEBRUARY 11, 1998 and examined and filed FEBRUARY 18, 1998.

Signed [Signature] Title COUNTY SURVEYOR



County Surveyor's Comment _____

