


CORNER RECORD

Document Number CR-98-12
County of San Joaquin, California

City of Stockton

Brief Legal Description NE 1/4 OF SECTION 45 OF C.M. WEBER GRANT, Book 19 of Surveys, Page 53, San Joaquin County Records

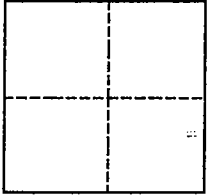

CORNER TYPE

Government Corner Control
Meander Property
Rancho Other
Date of Survey 2/2/97

COORDINATES

(Optional)

N. _____
E. _____
Zone _____ Datum _____
Elev. _____


Corner - Left as found Found and tagged Established Reestablished Rebuilt

Identification and type of corner found: Evidence used to identify or procedure used to establish or reestablish the corner : Found centerline monuments as shown on Record of Survey Bk. 19 of Surveys, Pg. 53 at the intersections of Main St. at Rendon Ave and Golden Gate Ave.

A description of the physical condition of the monument as found and as set or reset: Found monuments are railroad spikes in pavement with punch marks.

SURVEYOR'S STATEMENT

This Corner Record was prepared by me or under my direction in conformance with the Land Surveyors' Act on April 27, 19 98.
Signed Robert E. Chesner, L.S. Number 6670
Title SURVEYING SUPERVISOR, City of Stockton Public Works Department

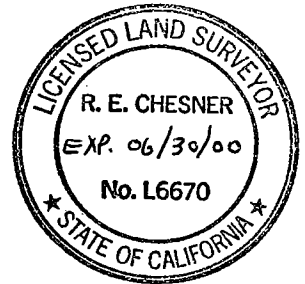

COUNTY SURVEYOR'S STATEMENT

This Corner Record was received JULY 27, 19 98 and examined and filed AUGUST 5, 19 98.
Signed Henry M. Hirata Title County Surveyor



County Surveyor's Comment _____

