


CORNER RECORD

Document Number CR-98-13  
County of San Joaquin, California

City of Stockton

Brief Legal Description NE 1/4 OF SECTION 45 OF C.M. WEBER GRANT, Book 19 of Surveys, Page 53, San Joaquin County

Records

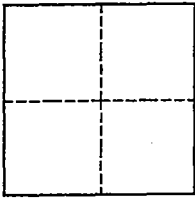

CORNER TYPE

Government Corner  Control   
Meander  Property   
Rancho  Other   
Date of Survey 8/2/97

COORDINATES  
(Optional)

N. \_\_\_\_\_  
E. \_\_\_\_\_  
Zone \_\_\_\_\_ Datum \_\_\_\_\_  
Elev. \_\_\_\_\_


Corner - Left as found  Found and tagged  Established  Reestablished  Rebuilt

Identification and type of corner found: Evidence used to identify or procedure used to establish or reestablish the corner : Centerline monuments at the intersections of Main Street and Golden Gate Ave. and Rendon Ave. were destroyed during construction. Reestablished using swing ties as shown on Corner Record CR98-12.

A description of the physical condition of the monument as found and as set or reset: Reset monuments are 1/2 inch rebars 30 inches long with plastic caps stamped "City of Stockton" and brass tags stamped "LS 6670" in cast iron monument boxes.

SURVEYOR'S STATEMENT

This Corner Record was prepared by me or under my direction in conformance with the Land Surveyors' Act on April 27, 19 98.  
Signed Robert E. Chesner, L.S. Number 6670  
Title SURVEYING SUPERVISOR, City of Stockton Public Works Department

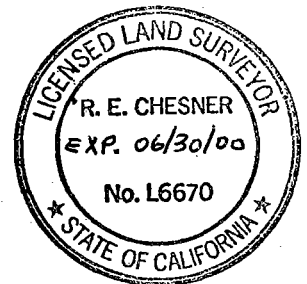

COUNTY SURVEYOR'S STATEMENT

This Corner Record was received JULY 27, 19 98 and examined and filed AUGUST 5, 19 98.  
Signed Henry M. Hirata Title County Surveyor



County Surveyor's Comment \_\_\_\_\_

