


CORNER RECORD

Document Number CR-99-2

City of _____

County of SAN JOAQUIN, California

Brief Legal Description T. 1 N., R. 8 E., M. D. B. E. M. R. S. 20-64

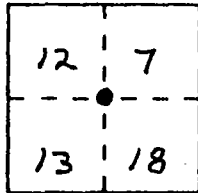

CORNER TYPE

Government Corner Control
 Meander Property
 Rancho Other
 Date of Survey 7-29-98

COORDINATES (Optional)

N. _____
 E. _____
 Zone _____ Datum _____
 Elev. _____

Corner — Left as found Found and tagged Established Reestablished Rebuilt


Identification and type of corner found: Evidence used to identify or procedure used to establish or reestablish the corner: FOUND R.R. SPIKE AS PER S.J. CO. RECORDS BOOK 20, PAGE 64, BOOK OF SURVEYS. NO ATTEMPT WAS MADE TO DETERMINE THE VALIDITY OF THE MONUMENT OR ITS PROPER LOCATION IN RELATION TO LEGAL BOUNDARY LINES IN THE AREA.

A description of the physical condition of the monument as found and as set or reset: SET MONUMENT WELL OVER FOUND MONUMENT AT SURFACE OF NEW PAVEMENT AS PER CALTRANS CONSTRUCTION PROJECT. MON. WAS COVERED AT SOME PREVIOUS TIME BY OTHER OVERLAYS. AFTER CONTRACTOR COMPLETED THIS PROJECT, MON. WAS FD. BY METAL DETECTOR, EXPOSED AND LEFT AS FD.

SURVEYOR'S STATEMENT

This Corner Record was prepared by me or under my direction in conformance with the Land Surveyors' Act on 7-29, 1998.

Signed W. J. Blair L.S. or R.C.E. Number 6489
 Expires 6-30-99

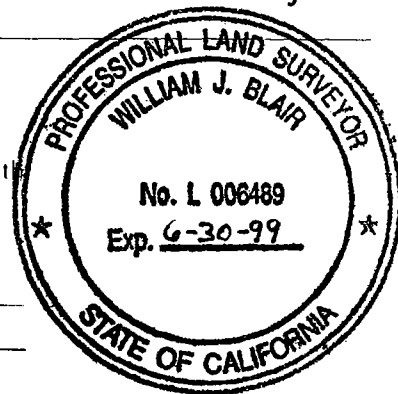

COUNTY SURVEYOR'S STATEMENT

This Corner Record was received DECEMBER 24, 1998 and examined and filed JANUARY 11, 1999.

Signed Henry M. Hirata Title COUNTY SURVEYOR



County Surveyor's Comment _____

