


CORNER RECORD

City of _____

Document Number CR-99-6
County of San Joaquin, California

Brief Legal Description TRACT No. 37 OAKRIDGE VOLUME 11, PG. 42 MAPS & PLATS
FRONT LOT CORNER OF LOTS 45/46 & 46/47

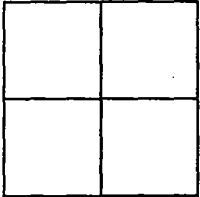

CORNER TYPE

- Government Corner Control
- Meander Property
- Rancho Other
- Date of Survey July, 1998

COORDINATES
(Optional)

N. _____
E. _____
Zone _____ Datum _____
Elev. _____

Corner - Left as found Found and tagged Established Reestablished Rebuilt

Identification and type of corner found: Evidence used to identify or procedure used to establish or reestablish the corner:

FOUND ORIGINAL MONUMENT AS NOTED : (SEE DIAGRAM ON REVERSE OF THIS SHEET)
AXLE AT B.C. Lot 45
" " Lot 14
1" IRON PIPE AT B.C. Lot 52
" " Lot 14 PER M&P 11-42

A description of the physical condition of the monument as found and as set or reset:

SET 1" X 30" IRON PIPE WITH PLASTIC CAP STAMPED: L.S. 6939
AT THE FRONT LOT CORNER OF LOTS 45/46 & 46/47
ALSO SET CHISELED CROSS N 89° 59' W, 139.00' FROM FRONT LOT CORNER OF Lot 46/47

SURVEYOR'S STATEMENT

This Corner Record was prepared by me or under my direction in conformance with

the Land Surveyors' Act on JANUARY 19, 19 99

Signed Michael D. Farley L.S. or R.C.E. Number 4.5.6939


COUNTY SURVEYOR'S STATEMENT

This Corner Record was received February 18, 19 99 and examined

and filed February 23, 19 99

Signed Henry M. Hirata Title COUNTY SURVEYOR

County Surveyor's Comment INITIAL SUBMITTAL OF THIS CORNER RECORD (1-25-99)
EXCEEDED THE MAXIMUM 90-DAY TIME LIMIT PER SUBDIVISION 464(C).

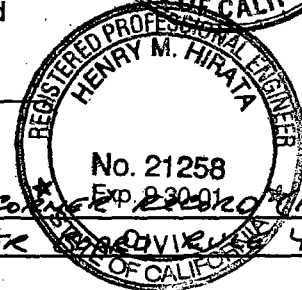

OAKRIDGE

VOL. 11, PG. 42 OF MAPS & PLATS
SAN JOAQUIN CO. RECORDS

LEGEND:

- FOUND MONUMENT AS NOTED PER "OAKRIDGE" VOL. 11, PG. 42
- + SET CHISELED CROSS
- SET 1" x 30" IRON PIPE WITH PLASTIC CAP STAMPED L.S. 6939
- / SFN SEARCHED, FOUND NOTHING
- M MEASURED
- R1 REFERENCE: "OAKRIDGE" VOL. 11, PAGE 42

