


# CORNER RECORD

City of Stockton

Document Number CR-99-15

County of San Joaquin, California

Brief Legal Description BOOK 30 OF SURVEYS, PAGE 17, SAN JOAQUIN COUNTY RECORDS.

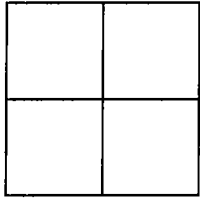

### CORNER TYPE

Government Corner  Control   
Meander  Property   
Rancho  Other   
Date of Survey 5/19/1999

### COORDINATES(Optional)

N. 2,208,840.524  
E. 6,310,242.341  
Zone 3 NAD27  NAD83   
Elev. 4.58  
Vert. Datum: NGVD29  NAVD88   
Meas. Units: Metric  Imperial

Corner - Left as found  Found and tagged  Established  Reestablished  Rebuilt

Identification and type of corner found: Evidence used to identify or procedure used to establish or reestablish the corner: City of Stockton control monument "9N-3" at the intersection of Eight Mile Rd. and the Westerly off-ramp for Interstate Highway 5 was destroyed during road reconstruction. Reestablished using found swing ties as shown in Book 30 of Surveys, Page 17.

A description of the physical condition of the monument as found and as set or reset: Found swing ties are chiseled crosses on concrete bases of street lights. Reset monument is a brass disk stamped "CITY OF STOCKTON SURVEY MONUMENT 9N-3 RESET 5/99 LS6670", set in concrete approximately 6 inches below the pavement surface inside a cast iron monument box.

### SURVEYOR'S STATEMENT

This Corner Record was prepared by me or under my direction in conformance with the Land Surveyor's Act on June 17, 1999.  
Signed Robert E. Chesner L.S. Number 6670  
Title City of Stockton Public Works Department Surveying Supervisor



### COUNTY SURVEYOR'S STATEMENT

This Corner Record was received AUGUST 9, 1999 and examined and filed AUGUST 12, 1999.  
Signed Henry M. Hirata R.C.E. No. 21258  
Title County Surveyor



County Surveyor's Comment \_\_\_\_\_

(D.D. Sheet No. 29A)


# LEGEND

- ⊙ SET MONUMENT IN BOX
- ⊗ STREET LIGHT
- FOUND SWING TIE
- "+" CHISELED CROSS

# REFERENCES

- (A) BK. 30 OF SURVEYS PG. 17
- (B) BK. 33 OF SURVEYS PG. 20

NOTE: BRASS DISK STAMPED.  
 "CITY OF STOCKTON SURVEY MONUMENT  
 9N-3 RESET 5/99 LS 6670"

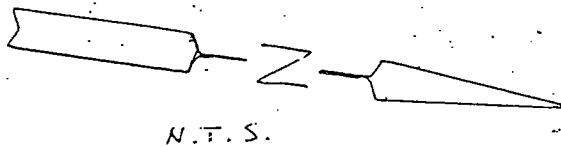

9N-3  
 (A)(B)  $X = 6,310,242.341$   
 $Y = 2,208,840.524$

$S 7^{\circ} 41' 42'' W$  76.15'  
 FND. "+" in Street Light Base (A)

FND. "+" in Street Light Base (A)  
 $S 52^{\circ} 37' 30'' E$  67.55'

EIGHT MILE ROAD

RESET BRASS DISK  
 IN CONCRETE, WITH  
 MONUMENT BOX

OFF-RAMP

INTERSTATE HWY. 5

ON-RAMP