


CORNER RECORD

City of ---

Document Number CR-99-19  
County of San Joaquin, California

Brief Legal Description Common corner to lots 60's 61, Amended Granada Glen of Linden

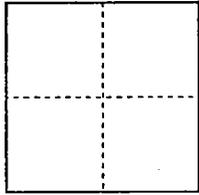

CORNER TYPE

Government Corner  Control   
Meander  Property   
Rancho  Other   
Date of Survey July 16, 1999

COORDINATES (Optional)

N. \_\_\_\_\_  
E. \_\_\_\_\_  
Zone \_\_\_\_\_ NAD27  NAD83   
NAD83 Epoch \_\_\_\_\_  
Elev. \_\_\_\_\_  
Vert. Datum: NGVD29  NAVD88   
Meas. Units: Metric  Imperial

Corner - Left as found  Found and tagged  Established  Reestablished  Rebuilt

Identification and type of corner found: Evidence used to identify or procedure used to establish or reestablish the corner:

see other side

A description of the physical condition of the monument as found and as set or reset: see other side

SURVEYOR'S STATEMENT

This Corner Record was prepared by me or under my direction in conformance with the Land Surveyors' Act on July 21, 19 99.

Signed Stephen R. Thumert L.S. or R.C.E. Number 4334



COUNTY SURVEYOR'S STATEMENT

This Corner Record was received October 11, 1999 and examined and filed October 18, 1999.

Signed Henry M. Hirata R.C.E. No. 21258


Title County Surveyor



County Surveyor's Comment \_\_\_\_\_

(D.D. Sheet No. 25)

FRONT STREET

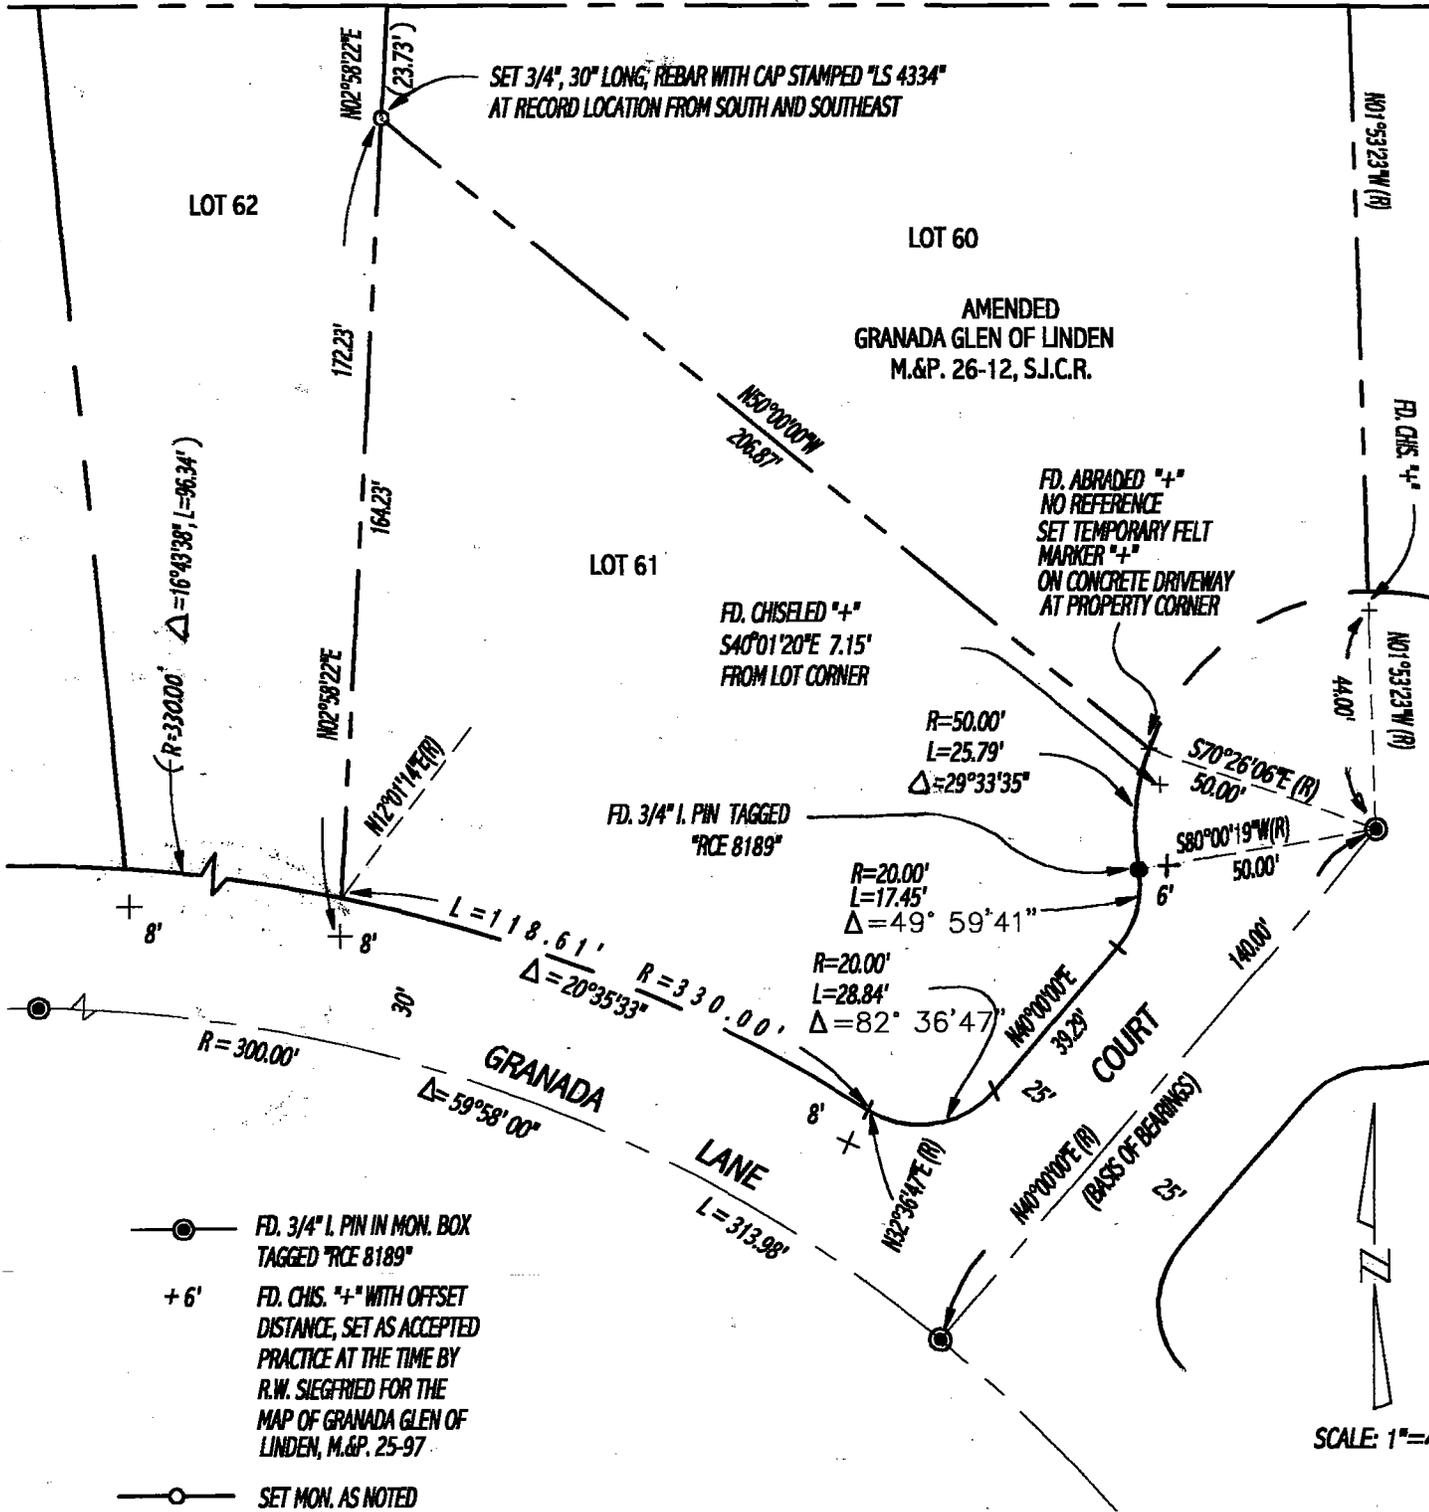

- FD. 3/4" I. PIN IN MON. BOX TAGGED "RCE 8189"
- + 6' FD. CHIS. "+ WITH OFFSET DISTANCE, SET AS ACCEPTED PRACTICE AT THE TIME BY R.W. SIEGFRIED FOR THE MAP OF GRANADA GLEN OF LINDEN, M.&P. 25-97
- SET MON. AS NOTED
- ( ) RECORD DATA PER M. & P. 25-97

