


CORNER RECORD

Document Number CR-99-24  
County of San Joaquin, California

City of \_\_\_\_\_

Brief Legal Description N/W corner of Section 30, T3N, R8E.,  
PER R.S. 16-33

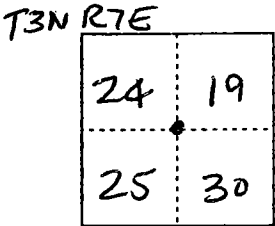

T3N R8E CORNER TYPE  
 Government Corner  Control   
 Meander  Property   
 Rancho  Other   
 Date of Survey 10-19-99

COORDINATES (Optional)  
 N. \_\_\_\_\_  
 E. \_\_\_\_\_  
 Zone \_\_\_\_\_ NAD27  NAD83   
 NAD83 Epoch \_\_\_\_\_  
 Elev. \_\_\_\_\_  
 Vert. Datum: NGVD29  NAVD88   
 Meas. Units: Metric  Imperial

Corner - Left as found  Found and tagged  Established  Reestablished  Rebuilt

Identification and type of corner found: Evidence used to identify or procedure used to establish or reestablish the corner:  
Found SJ Co. Pin & Washer <sup>1" Mon. 50%</sup> per RS-16-33 at  
intersection of Jack Tone Rd and Grassland Rd.  
No attempt was made to verify that found monument  
is monument as noted in RS-16-33

A description of the physical condition of the monument as found and as set or reset: Monument was in  
good condition and left as found. (Monument box was  
placed over monument during 1999 Jack Tone Road  
Resurfacing Project)

SURVEYOR'S STATEMENT

This Corner Record was prepared by me or under my direction in conformance with  
 the Land Surveyors' Act on 19 Oct, 1999.

Signed \_\_\_\_\_ R.C.E. Number 23341

COUNTY SURVEYOR'S STATEMENT

This Corner Record was received November 5, 1999 and examined  
 and filed December 3, 1999.

Signed Manuel Lopez R.C.E. No. 21258


Title \_\_\_\_\_ County Surveyor

County Surveyor's Comment \_\_\_\_\_



(D.D. Sheet No. 17&18 )

Jerry  
Violett

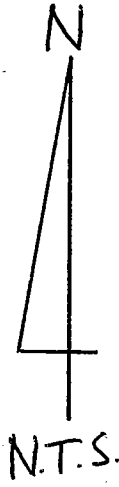

JP  
set

124<sup>21</sup>'

Fence Post  
set

44<sup>21</sup>'

TP  
set

118<sup>20</sup>'

Grassland Road

Road

Tone

Jack

Fd. S.J. Co  
Pin & Washer in  
Mon. Box

Note: "set" ties are nail &  
washers stamped  
"S.J. Co."