


CORNER RECORD

Document Number 00-04
County of San Joaquin, California

City of _____

Brief Legal Description INTERSECTION OF MARIPOSA ROAD AND BRENNAN ROAD

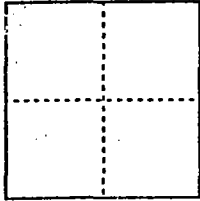

CORNER TYPE

- Government Corner Control
- Meander Property
- Rancho Other

Date of Survey 12-7-99

COORDINATES (Optional)

N. _____
 E. _____
 Zone _____ NAD27 NAD83
 NAD83 Epoch _____
 Elev. _____
 Vert. Datum: NGVD29 NAVD88
 Meas. Units: Metric Imperial

Corner - Left as found Found and tagged Established Reestablished Rebuilt


Identification and type of corner found: Evidence used to identify or procedure used to establish or reestablish the corner:
FOUND PIN & WASHER (NOT TAGGED)
PER SWING TIES ON C.R. 200-03.
SEE SKETCH ON BACKSIDE:

A description of the physical condition of the monument as found and as set or reset: FOUND ^{3/4"} PIN & WASHER (NOT TAGGED) IN GOOD CONDITION AND PLACED MONUMENT WELL OVER MONUMENT. SEE SKETH ON BACKSIDE.

SURVEYOR'S STATEMENT

This Corner Record was prepared by me or under my direction in conformance with the Land Surveyors' Act on 12/31/1999

Signed [Signature] L.S. or R.C.E. Number 23341

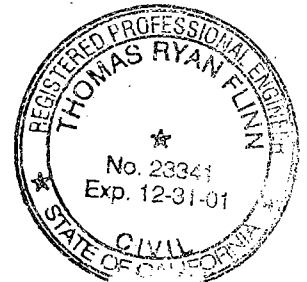

COUNTY SURVEYOR'S STATEMENT

This Corner Record was received 2-1-2000 and examined and filed 2-2-2000

Signed Henry M. Hirata R.C.E. No. 21258

Title County Surveyor



County Surveyors Comment _____

(D.D. Sheet No. 43)



POWER POLE
FOUND NAIL & SHINER.

FOUND $\frac{3}{4}$ " PIN & WASHER (NOT TAGGED)
(Placed Mon. Well
over Mon.)

40 61"

JOINT POLE
FOUND

MARIPOSA ROAD

BRENNAN ROAD

67 56"

TELEPHONE POLE
FOUND

ALL "FOUND" ^{ARE} CONCRETE
NAILS & BRASS WASHERS
STAMPED "S. J. CO."

"No attempt was made to verify Monument"