


CORNER RECORD

Document Number 00-08
County of San Joaquin, California

City of _____

Brief Legal Description S.E. Corner of S.W. 1/4 of Section 20, T.1S., R.8E. per
PM-20-178.

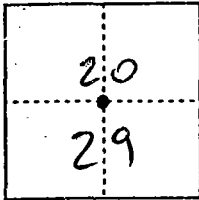

T.1S., R.8E.

CORNER TYPE

- Government Corner Control
- Meander Property
- Rancho Other

Date of Survey 12-9-99

COORDINATES (Optional)

N. _____
 E. _____
 Zone _____ NAD27 NAD83
 NAD83 Epoch _____
 Elev. _____
 Vert. Datum: NGVD29 NAVD88
 Meas. Units: Metric Imperial

Corner - Left as found Found and tagged Established Reestablished Rebuilt

Identification and type of corner found: Evidence used to identify or procedure used to establish or reestablish the corner:
Reestablished location of Found 12" Iron Pipe (Not Tagged) per PM-20-178
per Swing on C.R. 00-07.
ties See Sketch on Backside

A description of the physical condition of the monument as found and as set or reset: fd. 12" Iron Pipe (Not
Tagged) per PM-20-178 in good condition, reset 3/4" Rebar Tagged with Brass
Washer Stamped "S.J.Co." inside of 1/2" Iron Pipe per Swing on C.R. 99-
and placed Mon. Well over Mon.
See Sketch on Backside

SURVEYOR'S STATEMENT

This Corner Record was prepared by me or under my direction in conformance with
the Land Surveyors' Act on 12/31/1999


Signed [Signature] L.S. or R.C.E. Number 23341

COUNTY SURVEYOR'S STATEMENT

This Corner Record was received 2-1-2000, and examined
and filed 2-2-2000

Signed Henry M. Hirata R.C.E. No. 21258
Title County Surveyor

County Surveyors Comment _____

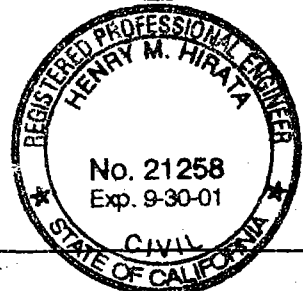

(D.D. Sheet No. 45)



Fd Chiseled
'4' on Corner
Gate Post

Fd Chiseled '4'
an Gate Post

31'6"

37'23"

89'65"

P.P.
Fd nail/washer
Road stamped
LS4450

Lone

Tree

63'60"

P.P.
Fd nail/washer
stamped "LS4450"

Road
Due

1/2" Iron
Pipe (Not Tagged) per TM-20-17
Set 3/4" x 30" Rebar
Tagged with Brass Washer
Stamped "S.J. Co." inside
Found 2" Pipe. Placed
Mon. Box over MON

"No attempt was made to verify Monument"